



**T27S, R33E,
SECTION 1, WM**


HARNEY COUNTY, OREGON

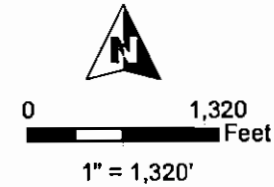

- POU Irrigation
- Township
- Section
- Quarter Quarter
- Taxlot
- Well

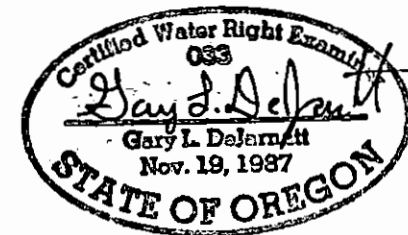

RENEWAL DATE 12/31/2015

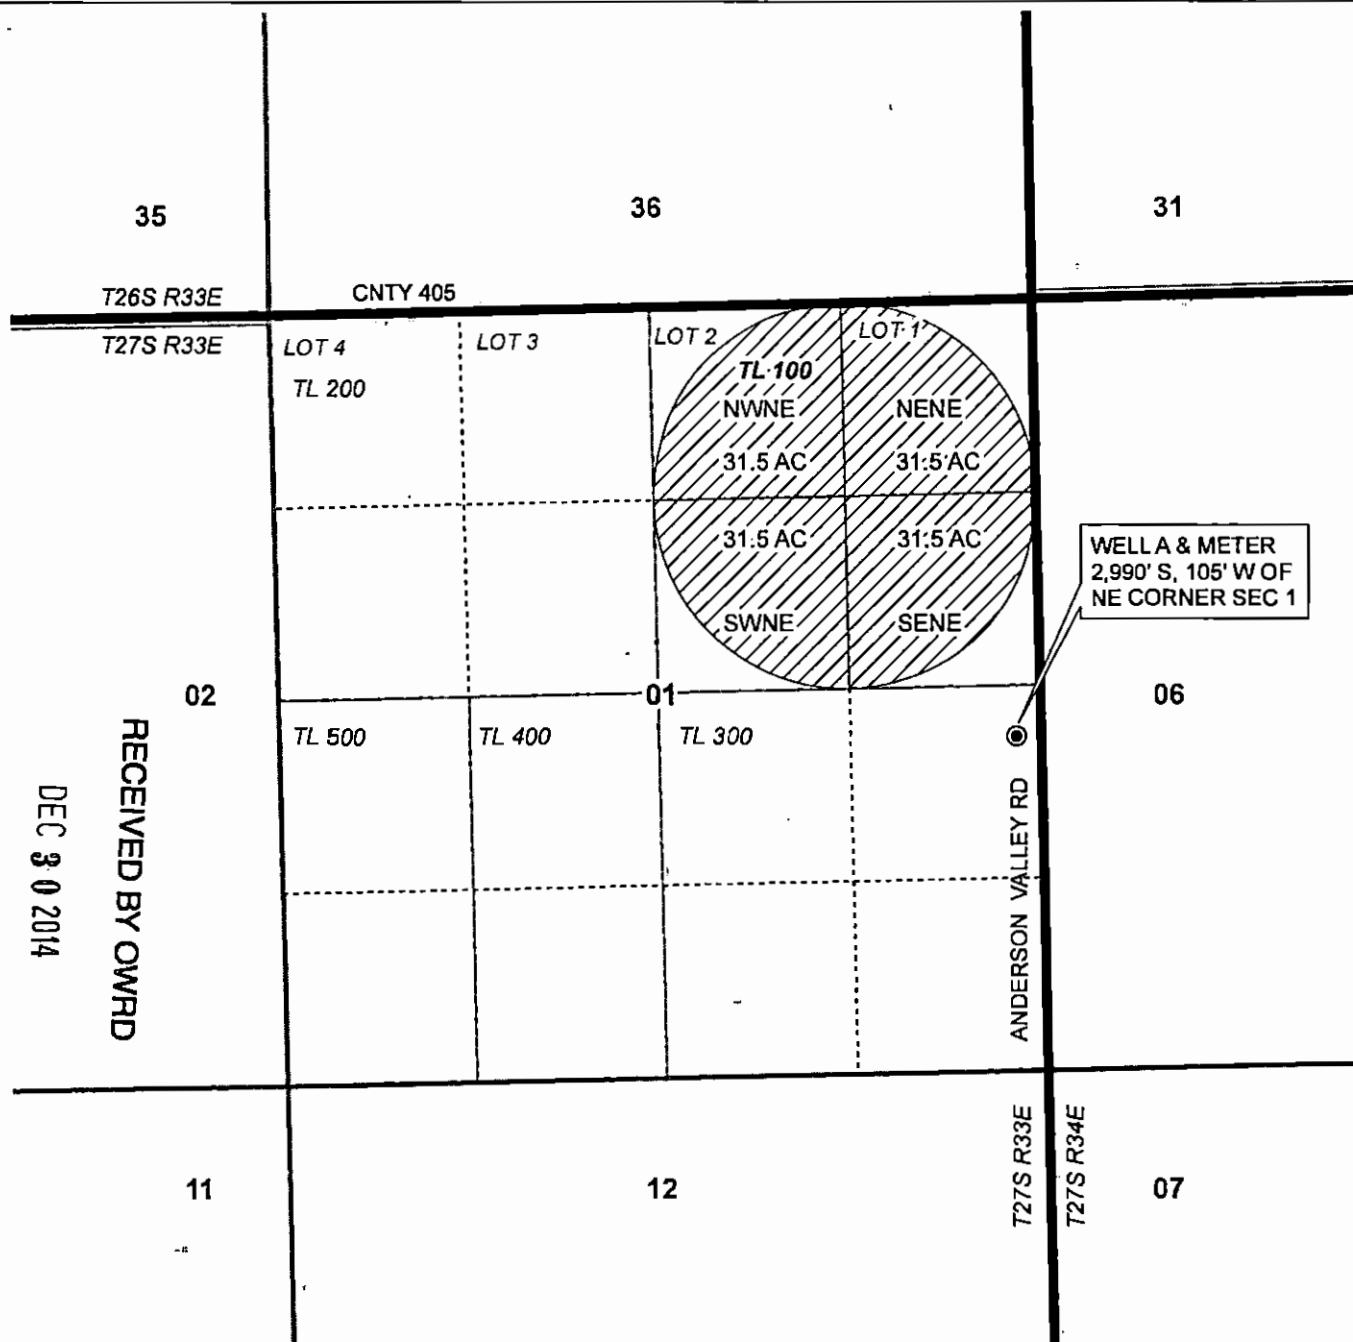

WELL & METER
2,990' S, 105' W OF
NE CORNER SEC 1

ANDERSON VALLEY RD

T27S R33E

T27S R34E

CLAIM OF BENEFICIAL USE MAP
Martin

NOTE: THIS MAP IS NOT INTENDED TO
PROVIDE LEGAL DIMENSIONS OR LOCATIONS
OF PROPERTY OWNERSHIP LINES.

WATER RIGHT SERVICES, LLC
PO BOX 1830, BEND, OR 97709
CCB# 1971214 www.oregonwater.us
541-389-2837 JOHNSHORT@USA.COM

APP G-16660 PERMIT G-16180 T-10994

PROJECT #14088

DECEMBER 2, 2014

RECEIVED BY OWRD

DEC 30 2014

SALEM, OR