


CLAIM OF BENEFICIAL USE MAP

FOR: JAMES L & DONNA ABERNATHY
 BY: NATHAN R. REED, CWRE
 T26S, R6W, W.M. SECTION 27 DLC 42
 APPLICATION NO. S-87758
 PERMIT NO. S-54822



DATE SURVEYED: MAY 14, 2014

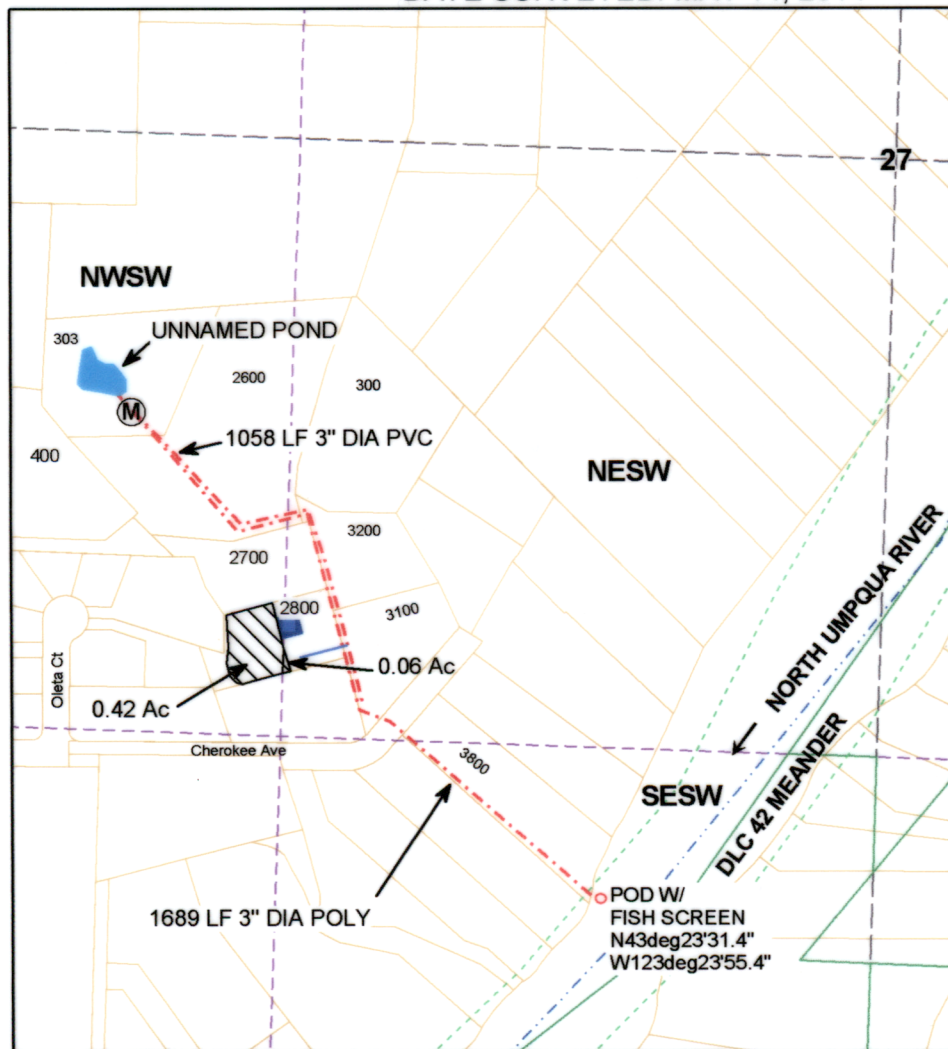

Legend

- Stream
- POD
- Main Pipe
- Pond
- Meter
- Lateral Line
- Structure
- Irrigation
- Meander
- Quarter
- Sixteenth
- Parcels

POD IS LOCATED 1640 FEET SOUTH AND 635 FEET WEST FROM THE CENTER OF SECTION 27.

MAP PREPARED FOR:
 JAMES L & DONNA ABERNATHY
 582 CHEROKEE AVE
 ROSEBURG, OR 97471

RECEIVED BY OWRD

MAY 19 2014

SALEM, OR



THE PURPOSE OF THIS MAP IS TO IDENTIFY THE LOCATION OF THE WATER RIGHT. IT IS NOT INTENDED TO PROVIDE INFORMATION RELATIVE TO THE LOCATION OF PROPERTY OWNERSHIP BOUNDARY LINES.

MAP PREPARED BY:
 NATHAN R. REED, P.E., CWRE
 1113 SE CASS AV
 ROSEBURG, OR 97470