


T. 39 S., R. 4 W., W.M.

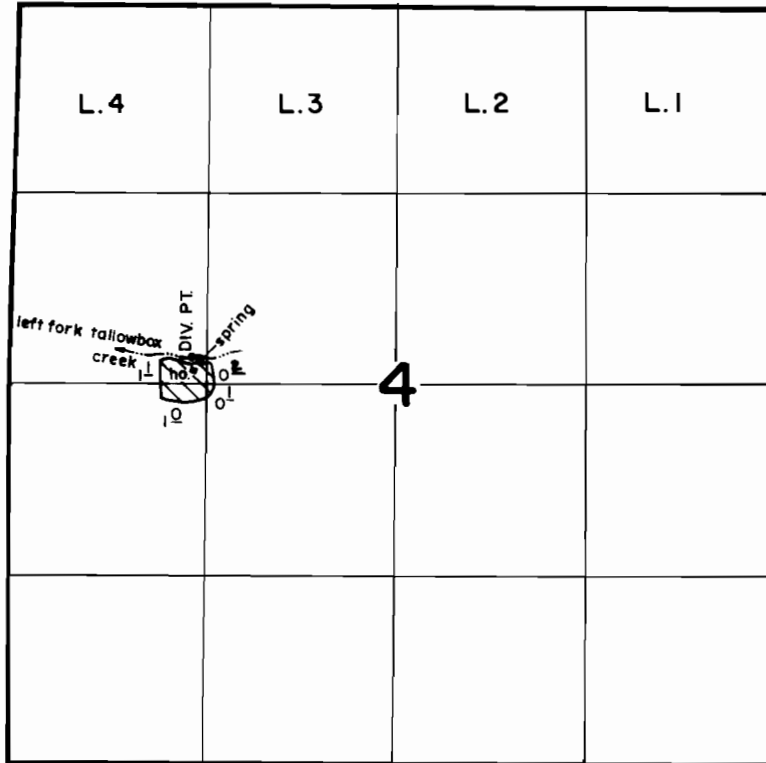

DIV. PT.: 190' N. & 1280' E.; SPRING: 150' N. & 1300' E.; both from W. 1/4 COR. SEC. 4

**FINAL PROOF SURVEY**  
UNDER

Application No. 50747 Permit No. 38327  
IN NAME OF

JOHN R. PALMER & JIM V. SKIBO

Surveyed MAY 13 1982, by BRUCE R. SUND

SCALE: 4" = 1 MILE