


NOTE:
THIS MAP IS NOT INTENDED TO PROVIDE
DIMENSIONS OR LOCATIONS OF PROPERTY
OWNERSHIP LINES.


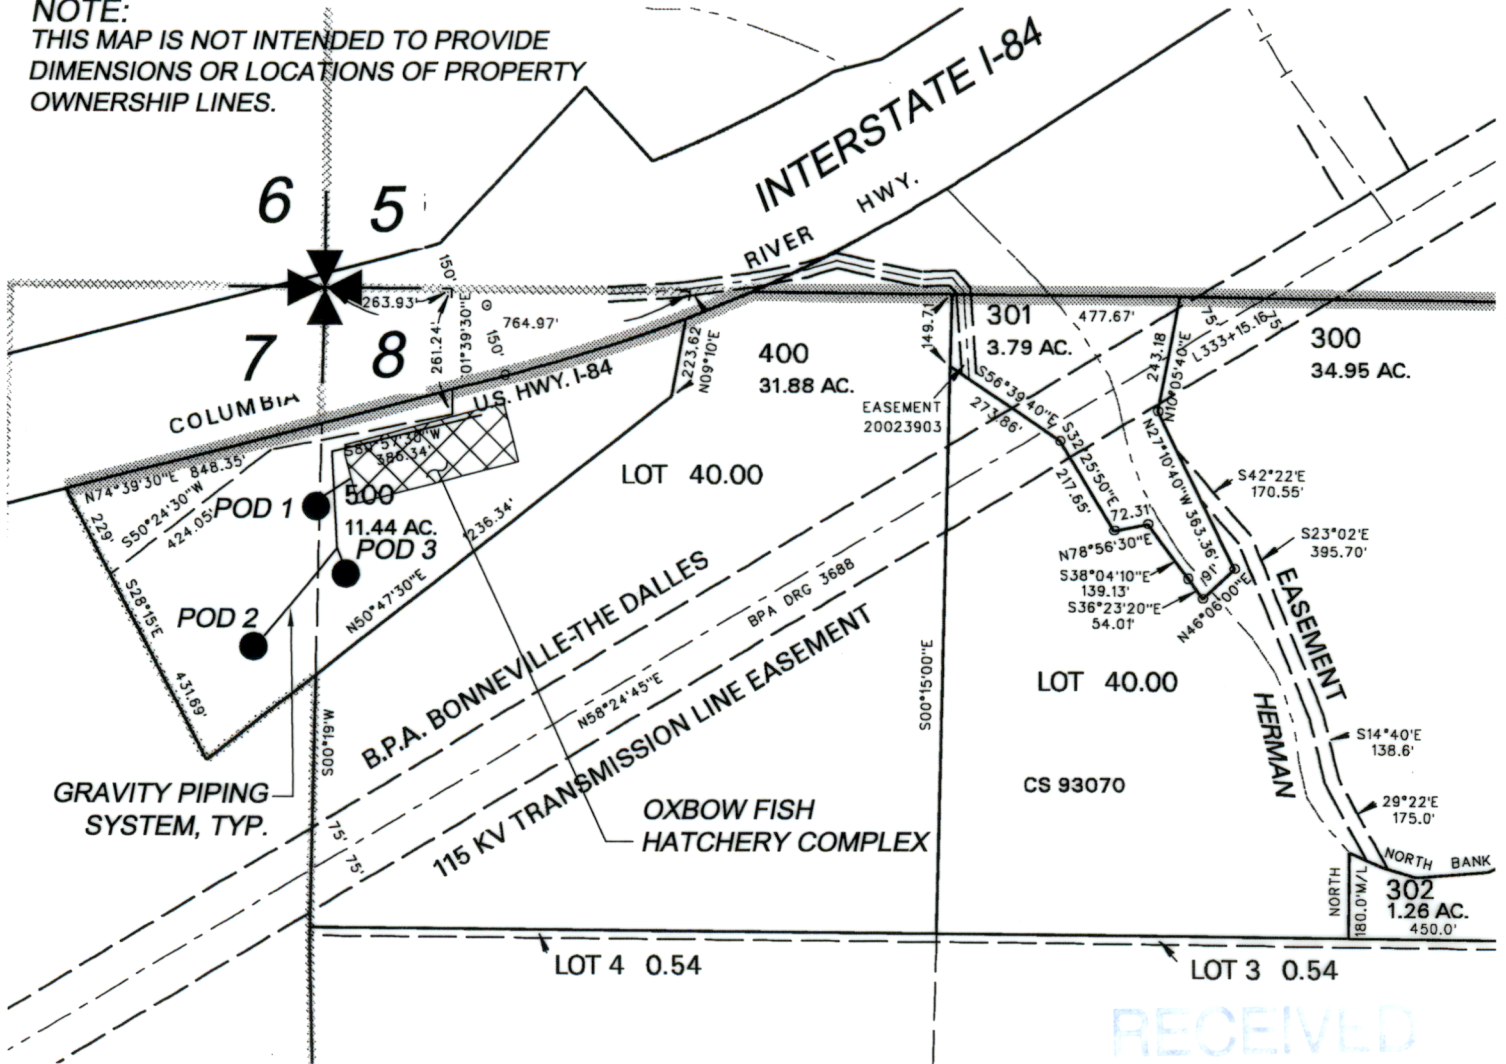


MAP: 02N 08E 08

RECEIVED

APR 13 2017

OVRC

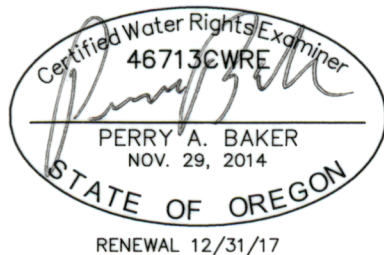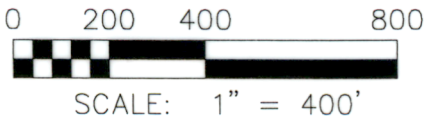

POD 1 - RESERVOIR (Little Herman Creek) - 450 Ft South and 5 Ft West of NE Corner SECTION 7 WITHIN THE NE 1/4 OF THE NE 1/4 OF SECTION 7, TWN 2N RNG 8E WM.

POD 2 - (Middle Spring) - 740 Ft South and 125 Ft West of NW Corner SECTION 8 WITHIN THE NE 1/4 OF THE NE 1/4 OF SECTION 7, TWN 2N RNG 8E WM.

POD 3 - (East Spring) - 590 Ft South and 50 Ft East of NW Corner SECTION 8 WITHIN THE NW 1/4 OF THE NW 1/4 OF SECTION 8, TWN 2N RNG 8E WM.

**OXBOW FISH HATCHERY
MAP FOR WATER RIGHT TRANSFER
T-11108 & T-11249**

SECTION 7 & 8, TWP 2 N., RANGE 8 E., W.M.
HOOD RIVER COUNTY, OREGON