CLAIM OF BENEFICIAL USE

APPLICATION S-87707 PERMIT S-54842

SECTION 18 & 19, T 36 S, R 2 W, WM. JACKSON COUNTY, OREGON

ASSESSOR'S MAP No 362W19-104, 602

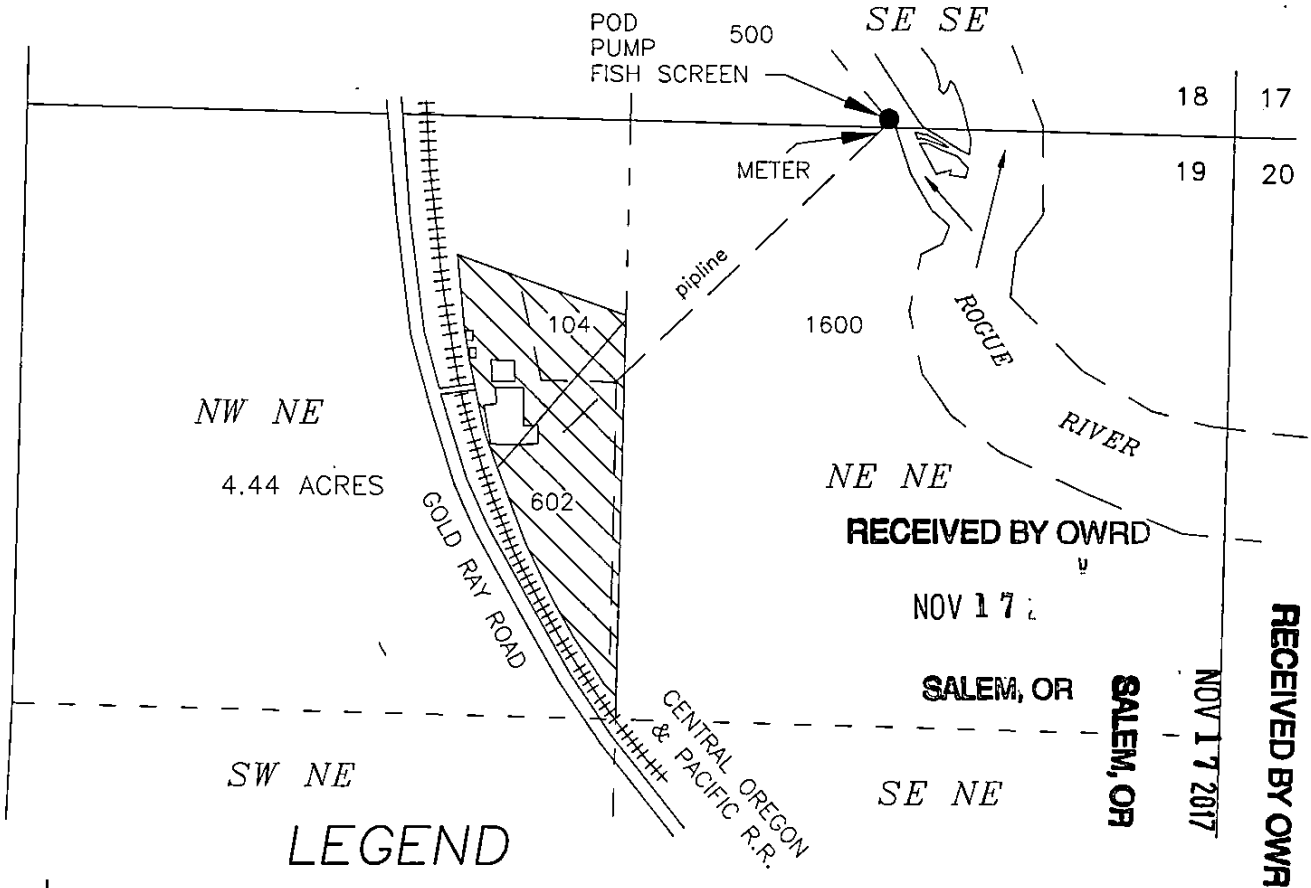

RECEIVED BY OWRD
NOV 17
SALEM, OR

RECEIVED BY OWRD
NOV 17 2017
SALEM, OR

LEGEND

● POD – SE/SE Section 18, 20 Feet North & 760 Feet West from the NE Corner of Section 19

Irrigation of 4.44 Acres
Source of water Lost Creek Lake Reservoir (R-8141 & R-8142)

ANGELA SCHOCK
8300 GOLD RAY ROAD
CENTRAL POINT, OR 97502

CERTIFIED WATER RIGHT EXAMINER
045
HERBERT A. FARBER
NOV 19, 1987
STATE OF OREGON
RENEWS: 12/31/2017

SCALE: 1" = 400'
0' 200' 400' 800'

This map is not intended to provide legal dimensions or locations of property ownership lines.

Prepared by:
FARBER & SONS, INC.
dba FARBER SURVEYING
(541) 664-5599
PO BOX 5286
431 OAK STREET
CENTRAL POINT, OREGON 97502

DATE: SEPTEMBER 15, 2014
JOB NO. 1829-11

FILE: JOBS\willow springs\gold ray road\shock\micro\schockv2000.dwg