

CLAIM OF BENEFICIAL USE  
 APPLICATION S-87917 - PERMIT S-54851  
 FOR  
 JOHN DAVID FILIPOWICZ  
 AND

SHARON LOUISE FEIL-FILIPOWICZ  
 13397 OREGON STATE HIGHWAY NO. 234  
 GOLD HILL, OR 97525  
 GOVERNMENT LOT 5 (SE1/4NE1/4, NE1/4SE1/4) SECTION 10  
 TOWNSHIP 36 SOUTH, RANGE 3 WEST, W.M.  
 JACKSON COUNTY, OREGON




Scale: 1"=400'  
 Date: July 16, 2014

**LEGEND**

- Found Survey Monument SN 18456
- Denotes Building
- === Denotes Driveway
- △ Denotes Point Of Diversion No. 1, Location of Pump, Flow Meter and Fish Screen
- Ⓜ Denotes Flow Meter
- ▨ Denotes Area Under Permit S-54851, Priority Date July 15, 2013


Point of Diversion No. 1—Situated 295' South and 440' West from the East 1/4 corner Section 10.

This map was prepared for the purpose of identifying the location of a water right only and is not intended to provide legal dimensions or location of property ownership.

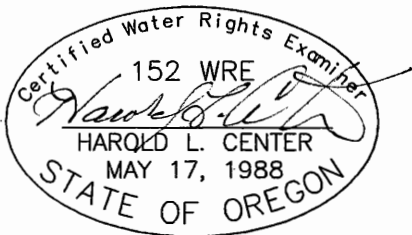

Renews: 12/31/15

HAROLD L. CENTER  
 2604 David Lane  
 Medford, OR. 97504  
 Phone 541-535-6108  
 Oregon Certificate No. 152

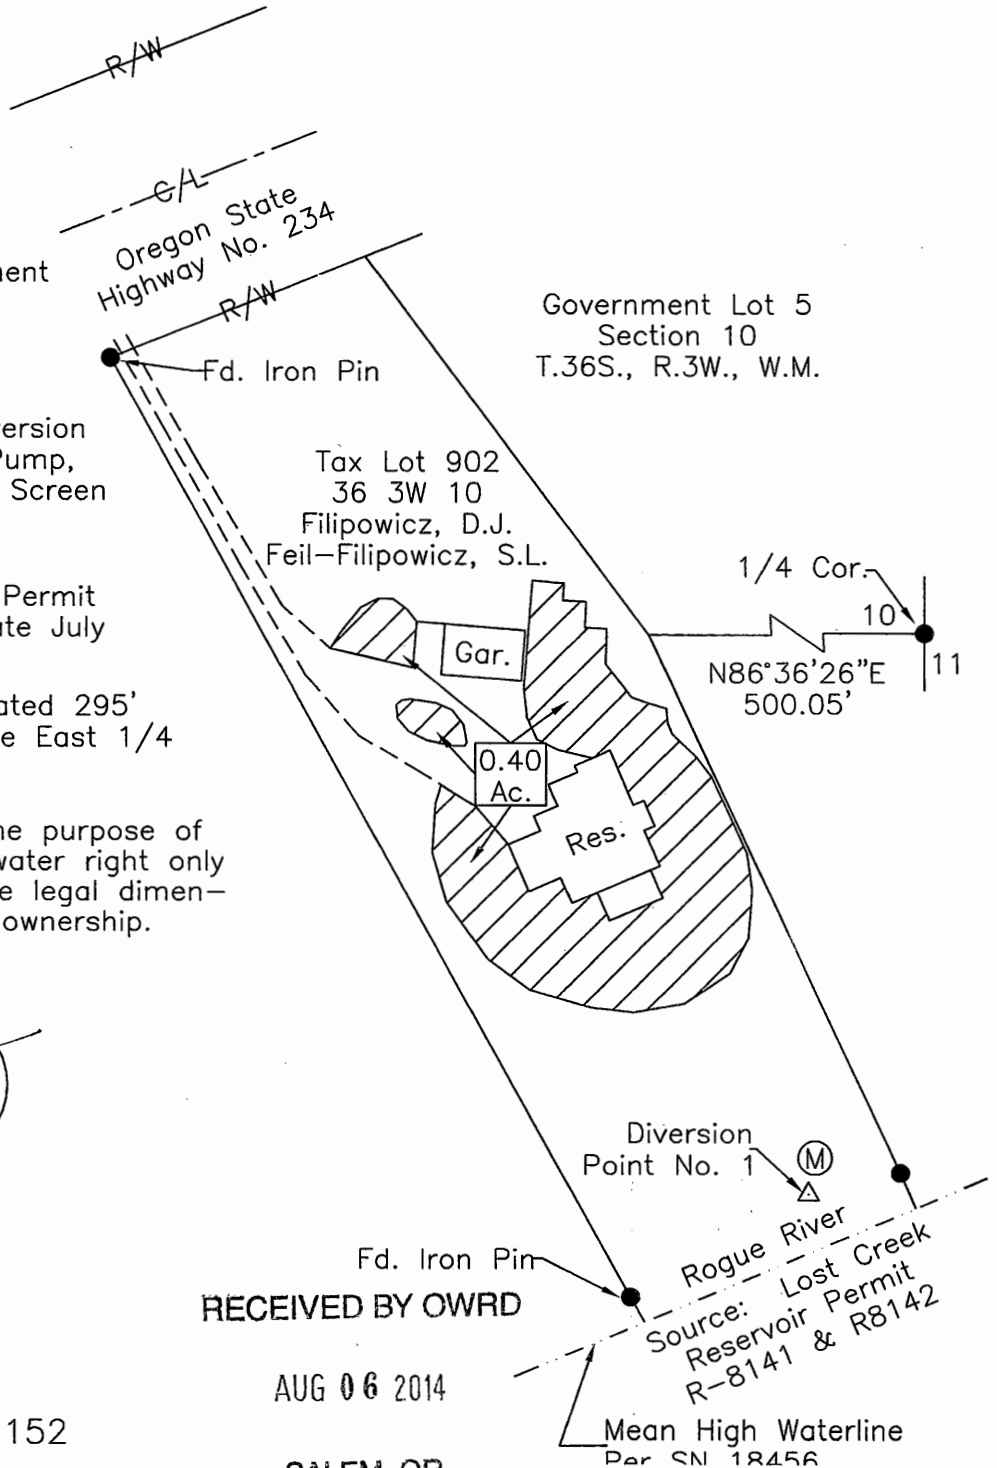

RECEIVED BY OWRD

AUG 06 2014

SALEM, OR