

**OWNERS MAILING ADDRESS:**

TEAL FLEMING  
PO BOX 932  
PORT ORFORD, OR 97465

**RECORD INFORMATION**

"JACQUES PARTITION" 2009-06,  
CURRY COUNTY SURVEY RECORDS,

**DEED INFORMATION**

DEED INST. #2009-5219 CURRY  
COUNTY RECORDS

**CLAIM OF BENEFICIAL USE FINAL PROOF WATER RIGHTS SURVEY MAP FOR:**



**TEAL FLEMING**

**APPLICATION NUMBER: S-87394, PERMIT: S-54601**

**PROPERTY LOCATED IN THE:**

**SW 1/4 OF SECTION 10, T33S, R15W, W.M. CURRY COUNTY, OREGON**

**TAX MAP DESIGNATION: 33S 15W 10C T.L. 202**

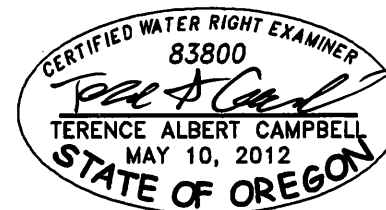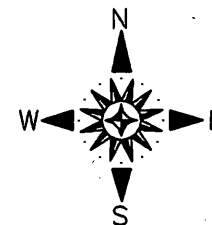

RENEWS 12/31/2015

POINT OF DIVERSION IS S69W, 127' FROM THE NE  
COR OF GOVT LOT 3 IN SEC. 10, T 33 S, R 15  
W.W.M, CURRY COUNTY, OREGON

POINT OF DIVERSION IS ALSO 45' SOUTH AND 119'  
WEST OF THE NE COR OF GOVT LOT 3 IN SEC. 10, T  
33 S, R 15 W.W.M, CURRY COUNTY, OREGON

POD COORDINATES REFERENCED TO  
THE OREGON STATE PLANE SOUTH ZONE:

NORTHING: 412,149  
EASTING: 3,856,606

\*\*LOCATIONS OF FEATURES WERE OBTAINED USING  
A COMBINATION OF CONVENTIAL TRAVERSE AND  
GPS SURVEYING.

**LEGEND**

- GOVERNMENT CORNER
- POINT OF DIVERSION
- HYDRAULIC RAM PUMP
- 1550 GALLON WATER TANK
- PLACE OF USE - EXISTING RESIDENCE
- WATER METER
- DIRECTION OF DIVERTED WATER THROUGH SYSTEM

UNNAMED STREAM,  
A TRIBUTARY OF  
THE PACIFIC OCEAN

TAX LOT 102  
MAP 33-15-10C

TAX LOT 202  
MAP 33-15-10C

TAX LOT 200  
MAP 33-15-10C

TAX LOT 203  
MAP 33-15-10C

BRIDGE HAS COLLAPSED NE CORNER  
GOVT. LOT 3

RECEIVED BY OWR

AUG 06 2014

SALEM, OR

**SCALE**



( IN FEET )  
1 inch = 200 ft.

THE PURPOSE OF THIS MAP IS TO IDENTIFY THE LOCATION OF THE WATER RIGHT. THIS MAP IS NOT  
INTENDED TO PROVIDE LEGAL DIMENSIONS OR LOCATIONS OF PROPERTY OWNERSHIP LINES



87833 Dew Valley Lane  
Bandon, Oregon 97411  
541-294-9642

PAGE 1 OF 1

BANDON SURVEYING

bandonsurveyor@gmail.com

www.bandonsurveying.com

FLEMING FINAL PROOF SURVEY MAP

33-15-10C-TL 202

SCALE: 1" = 200'

DATE: JULY 13, 2014

DESIGNED BY: T. CAMPBELL

DRAWN BY: T. CAMPBELL



87833 Dew Valley Lane  
Bandon, Oregon 97411  
541-294-9642