


870

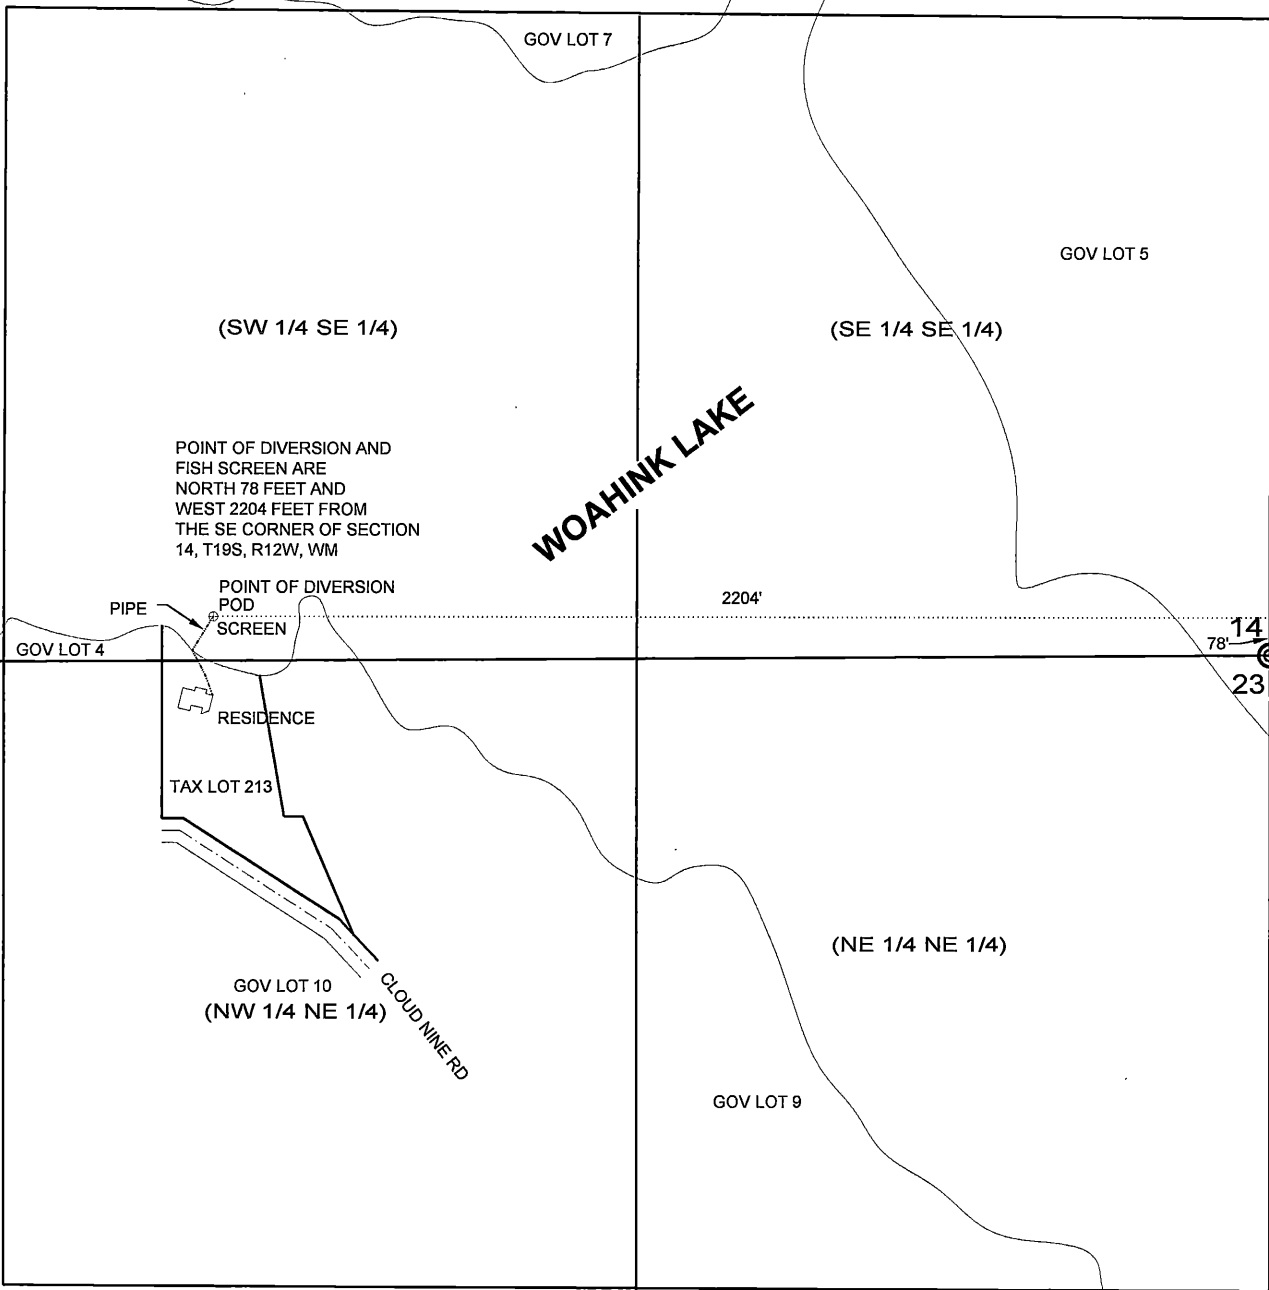

COBLE MAP 870

# CLAIM OF BENEFICIAL USE WATER RIGHTS MAP

MID COAST BASIN  
UNDER  
APPLICATION S-73745  
PERMIT S-52544

RECEIVED BY OWRD

NOV 07 2014

SALEM, OR

POINT OF DIVERSION  
SW 1/4, SE 1/4, SEC 14, T19S, R12W, W.M.  
PLACE OF USE  
NW 1/4, NE 1/4, SEC 23, T19S, R12W, W.M.  
19-12-23-1, T.L. 213  
DUNES CITY

Water Right #