


# AVION WATER CO. INC.

CLAIM OF BENEFICIAL USE  
Transfer T-11994  
Deschutes County

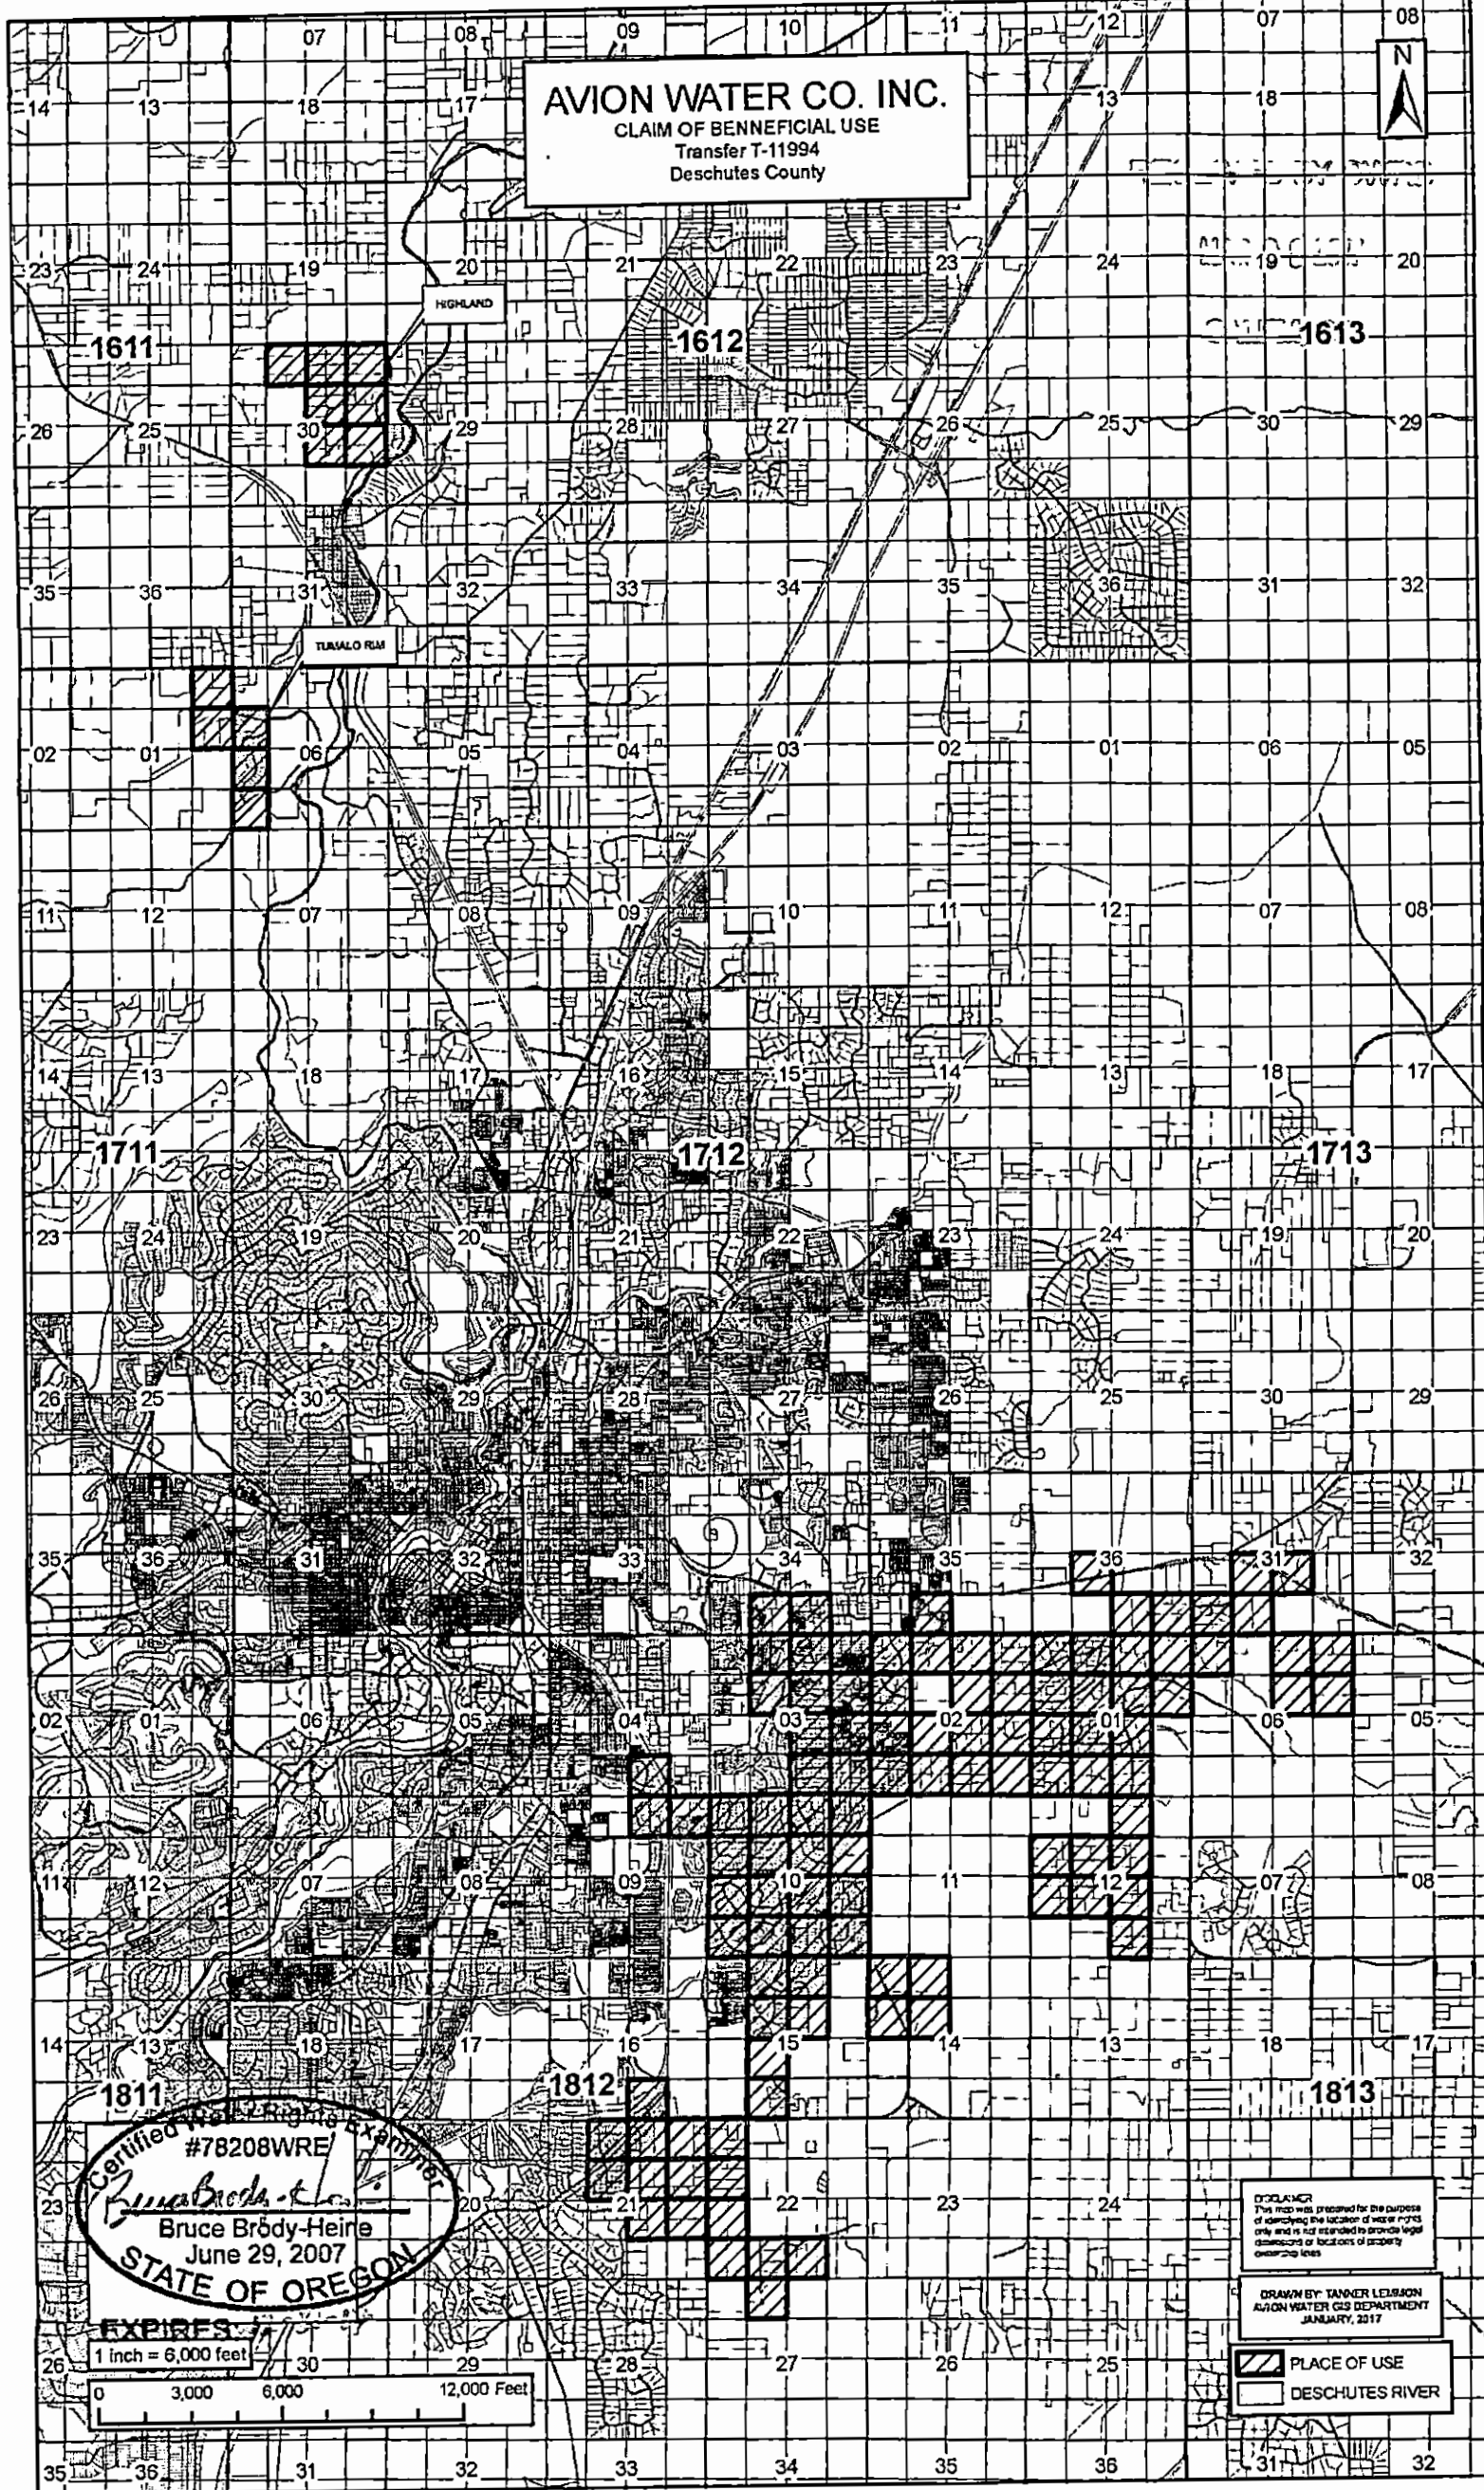

Certified Public Rights Examiner  
#78208WRE  
*Bruce Brödy-Heire*  
Bruce Brödy-Heire  
June 29, 2007  
STATE OF OREGON

EXPIRES  
1 inch = 6,000 feet  
0 3,000 6,000 12,000 Feet

DISCLAIMER  
This map was prepared for the purpose of showing the location of water rights only and is not intended to provide legal opinions or locations of property ownership lines.

DRAWN BY: TANNER LEISSON  
AVION WATER GIS DEPARTMENT  
JANUARY, 2017

PLACE OF USE  
 DESCHUTES RIVER