


ACMPC Oregon 3, LLC Neck Rd. farm

Revised 4-21-16 WEM

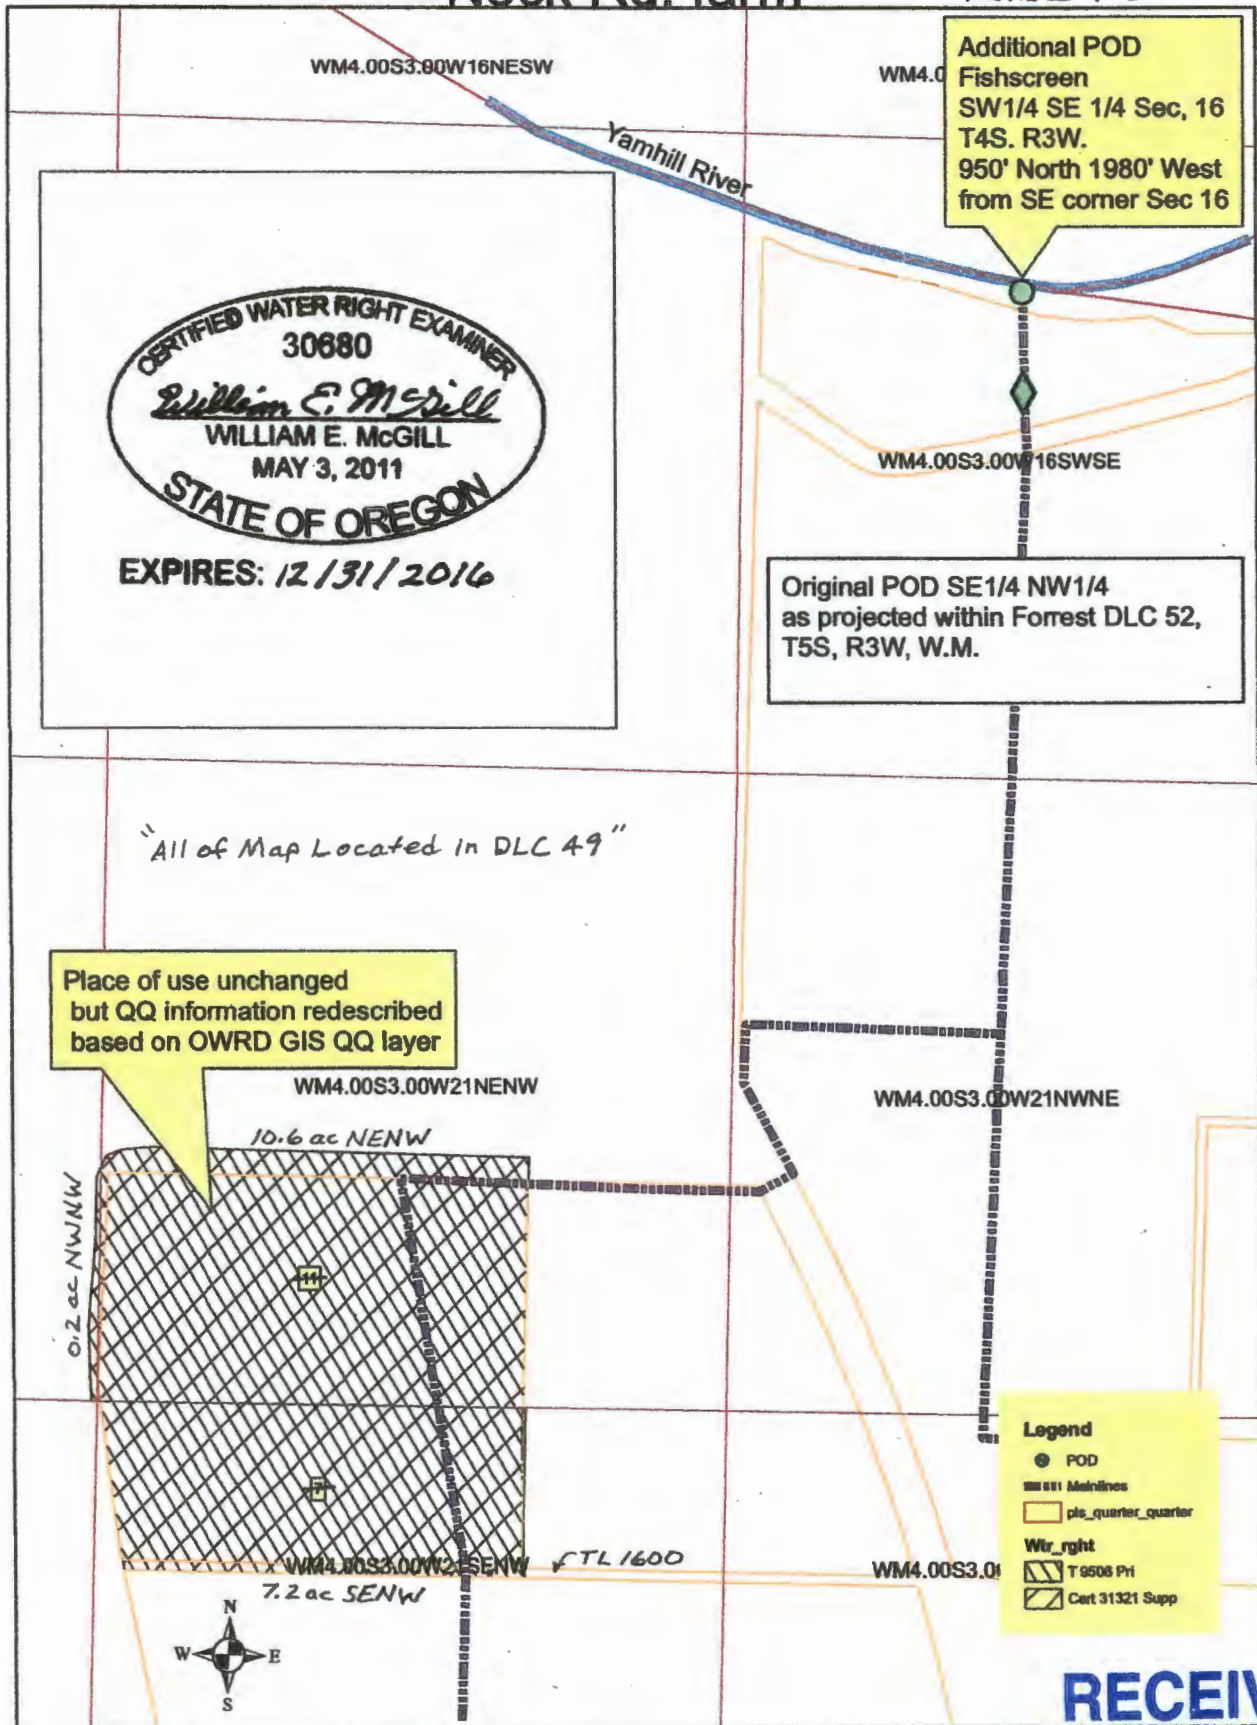

RECEIVED


Cert 31321 Additional POD map
Prepared by Stevenson/McGill

APR 21 2016

WATER RESOURCES DEPT
SALEM, OREGON

T-12306

ACMPC Oregon 3, LLC Neck Rd. farm

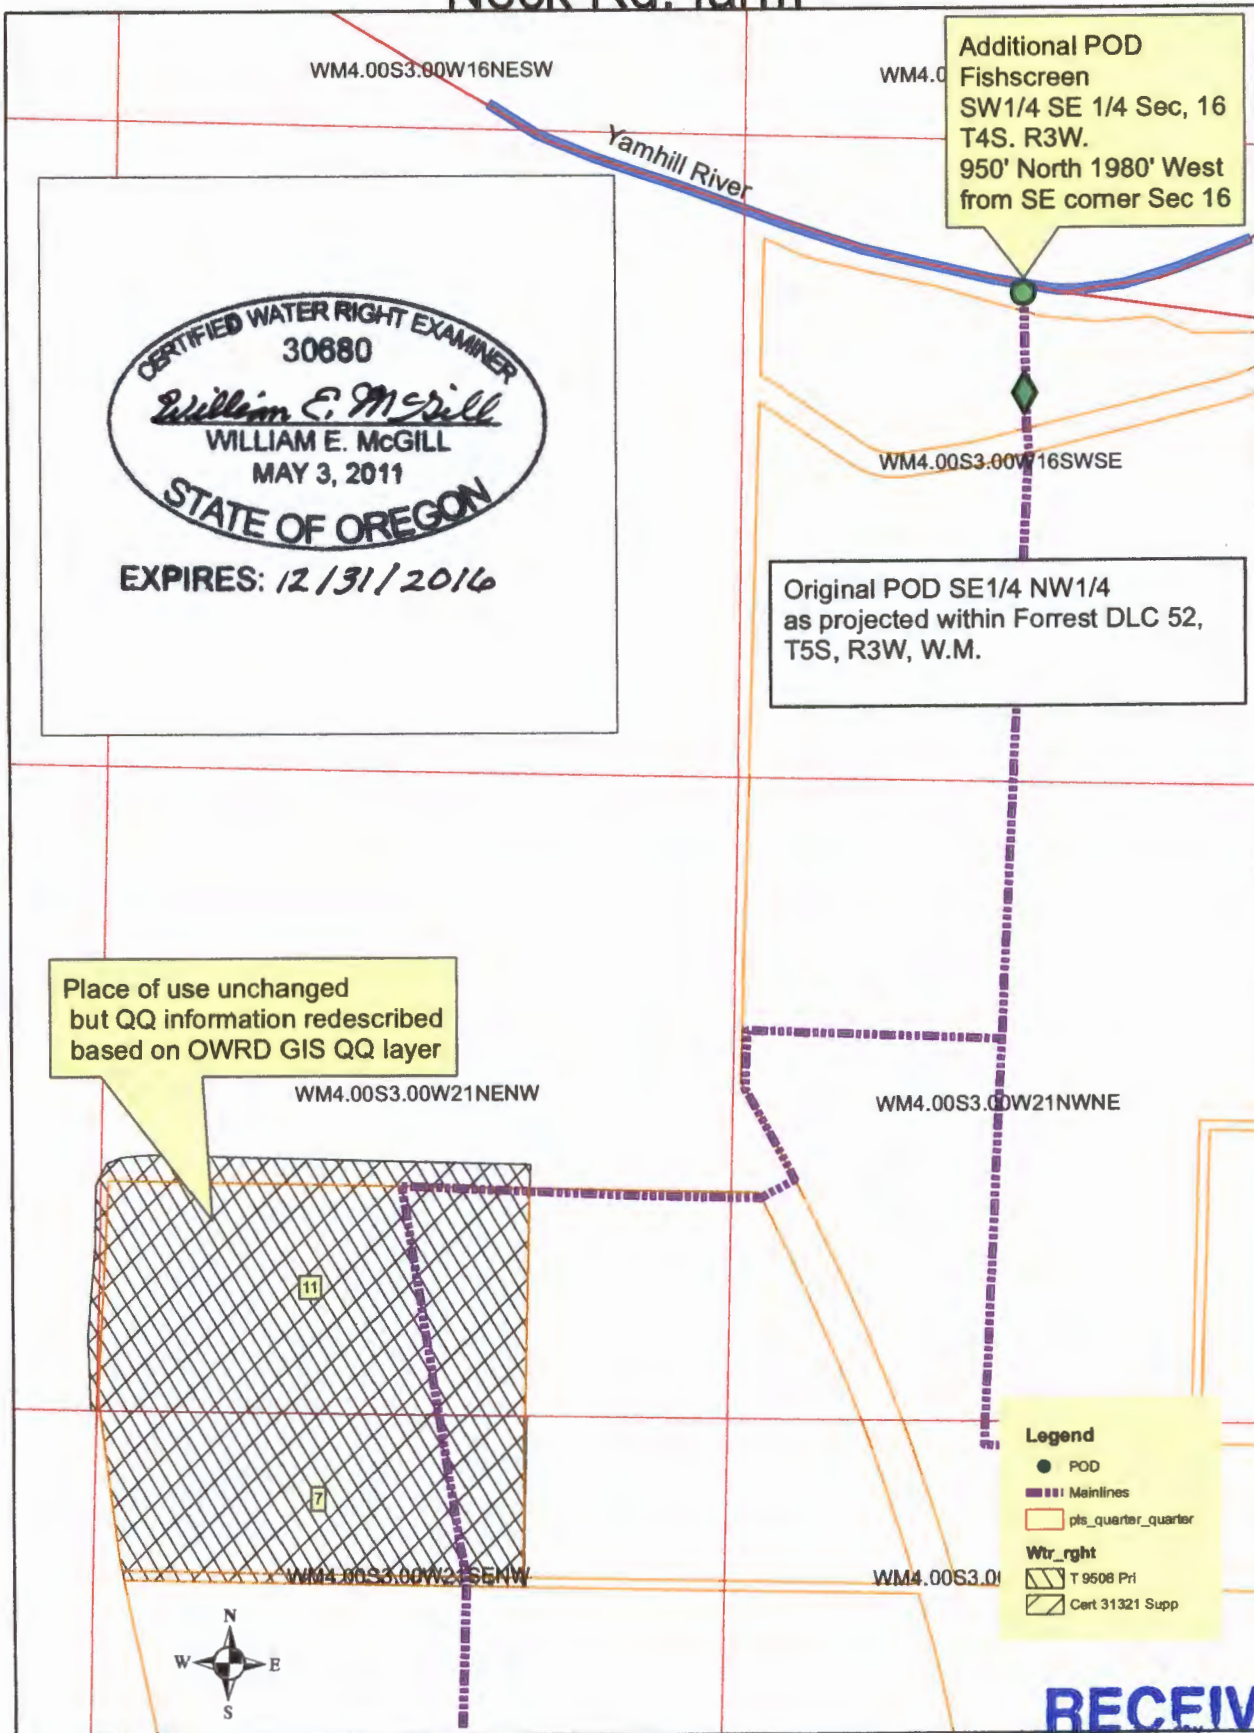

CERTIFIED WATER RIGHT EXAMINER
 30680
William E. McGill
 WILLIAM E. MCGILL
 MAY 3, 2011
STATE OF OREGON
 EXPIRES: 12/31/2016

Original POD SE1/4 NW1/4 as projected within Forrest DLC 52, T5S, R3W, W.M.

RECEIVED

Cert 31321 Additional POD map
Prepared by Stevenson/McGill

MAR 11 2016

T 12306

WATER RESOURCES DEPT
SALEM, OREGON