


T 24 S, R 34 E, WM

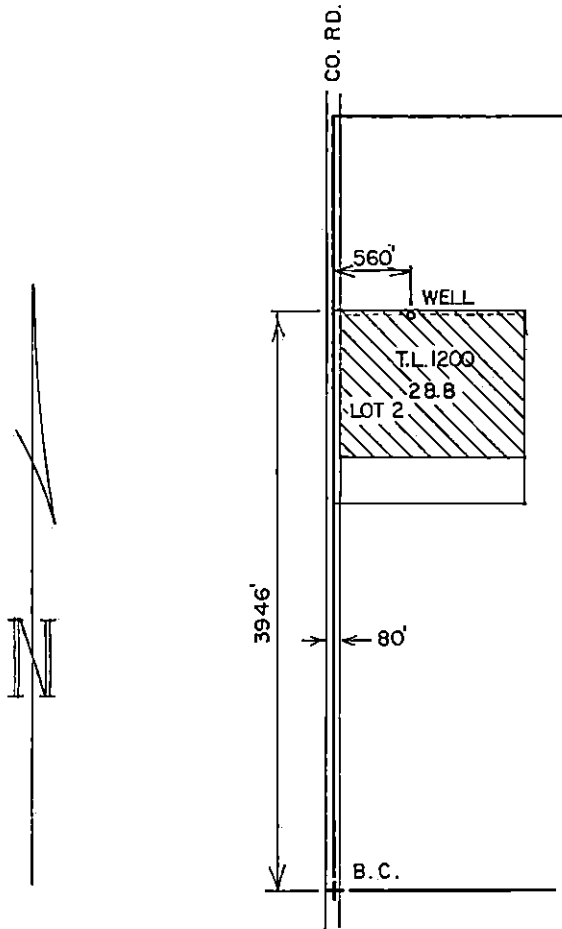

19

THE PURPOSE OF THIS MAP IS TO
IDENTIFY THE LOCATION OF THE
WATER RIGHT. IT IS NOT INTENDED
TO PROVIDE INFORMATION RELATIVE
TO THE LOCATION OF PROPERTY
OWNERSHIP

RECEIVED

APR 21 2003

WATER RESOURCES DEPT,
SALEM, OREGON

FINAL PROOF SURVEY

UNDER
APPLICATION G-14226
PERMIT G-13214

IN THE NAME OF
CLARANCE PHILLIS

Scale: 4" = 1 MILE

Date: APR. 2003

Job: 1215-03

Dsn:

Drn: CHRIS

Ckd:

MAP's

M. A. PALMER & SONS, INC.
ENGINEERING & SURVEYING
254 N. Alder - Box 61
Burns, Oregon 97720

Sht. No.

of 1

STATE OF OREGON
RENEW 1-1-2005