



MAP FOR

Claim of Beneficial Use

S24, T1N, R4W, WASHINGTON COUNTY

Appl G-17018, Permit G-16586

1 IN = 400 FT
0 200 400

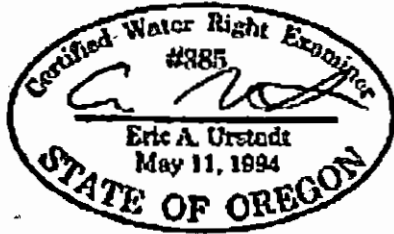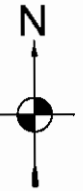

S14 S13 KEMPER ROAD
S23 S24

TL 300, S24

5.7 AC IRRIGATION NW-NW

OVERHEAD POWERLINE EASEMENT

Well #1 AND METER

RECOVERY POND FOR NURSERY OPERATIONS

13.1 AC NURSERY SE-NW GLOT 1

18.9 AC IRRIGATION SW-NW GLOT 3

1.0 AC NURSERY

THATCHER ROAD







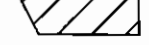

SHOP BUILDINGS

WELL #1 POD1 IS 2000' SOUTH AND 330' WEST FROM THE NW CORNER S24.

RECEIVED BY OWRD

NOTES:
 THIS MAP IS NOT INTENDED TO PROVIDE LEGAL DIMENSIONS OR LOCATIONS OF PROPERTY OWNERSHIP LINES.
 -PROPERTY LINES AND QUARTER-QUARTER LINES ARE BASED ON THE TAX ASSESSOR MAP FOR SECTION 24, T1N, R4W.
 -WATER CONVEYANCE LINES ARE ALL WITHIN THE PROPERTY AND THEREFORE ARE NOT SHOWN.
 -THE WATER RIGHT IS NOT WITHIN A DONATION LAND CLAIM.
 -NO SURFACE WATER OTHER THAN THE RESERVOIR IS NEAR THE SITE.
 -WATER RIGHT USAGE IS DETERMINED FROM AN AERIAL PHOTO FROM THE ORMAP WEBSITE.

LEGEND

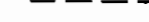-  SECTION CORNER
-  POINT OF APPROPRIATION (WELL)
-  TAX LOT LINE
-  SECTION LINE
-  QUARTER-QUARTER LINE
-  DLC LINES (NOT SHOWN)
-  NURSERY CROPS
-  NORMAL IRRIGATION

APR 2 2017

3/15/17, OF

MAP BY:
ASPEN RURAL LAND CONSULTING
 ERIC URSTADT, PE, PLS
 971-250-1520
 Mar 2017
 Roofener1D




MAP FOR

Claim of Beneficial Use

S24, T1N, R4W, WASHINGTON COUNTY

Appl G-17018, Permit G-16586

1 IN = 400 FT
0 200 400

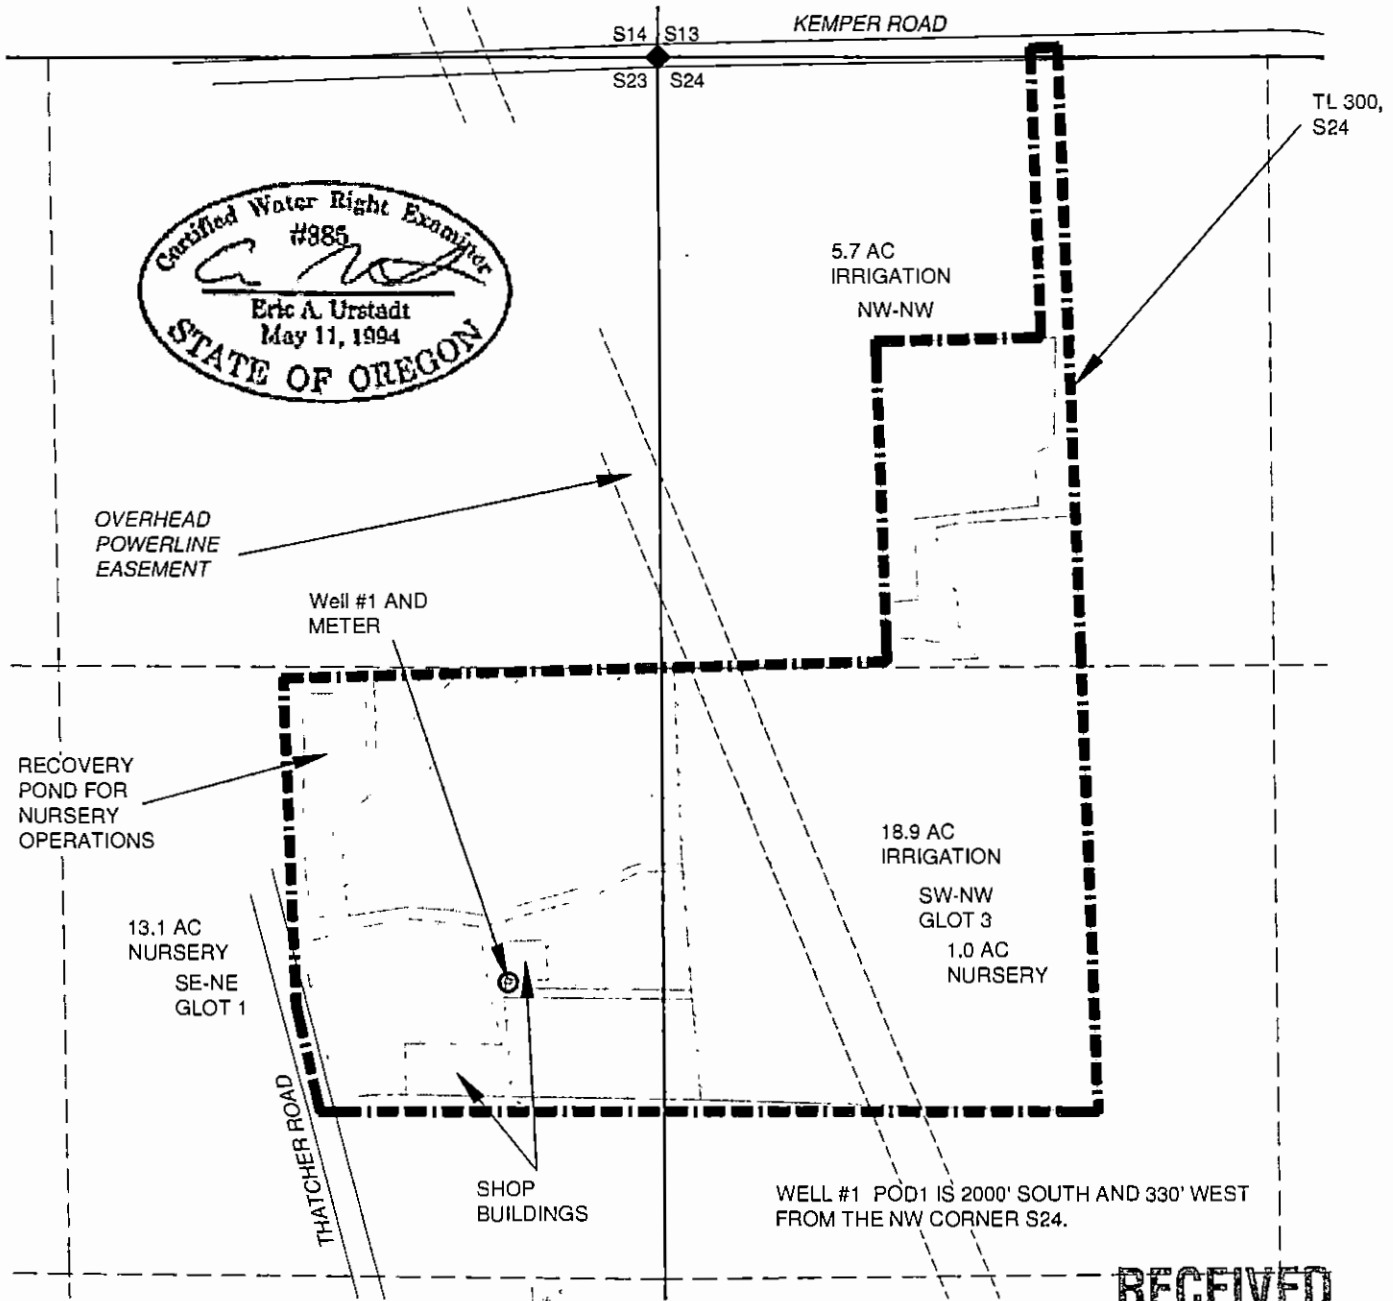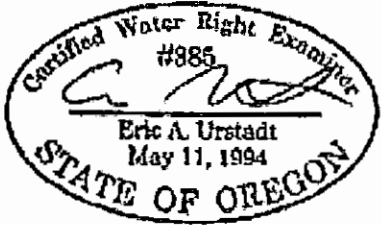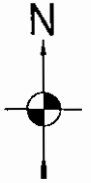

NOTES:

- THIS MAP IS NOT INTENDED TO PROVIDE LEGAL DIMENSIONS OR LOCATIONS OF PROPERTY OWNERSHIP LINES.
- PROPERTY LINES AND QUARTER-QUARTER LINES ARE BASED ON THE TAX ASSESSOR MAP FOR SECTION 24, T1N, R4W.
- WATER CONVEYANCE LINES ARE ALL WITHIN THE PROPERTY AND THEREFORE ARE NOT SHOWN.
- THE WATER RIGHT IS NOT WITHIN A DONATION LAND CLAIM.
- NO SURFACE WATER OTHER THAN THE RESERVOIR IS NEAR THE SITE.
- WATER RIGHT USAGE IS DETERMINED FROM AN AERIAL PHOTO FROM THE ORMAP WEBSITE.

LEGEND

- ◆ SECTION CORNER
- Ⓟ POINT OF APPROPRIATION (WELL)
- TAX LOT LINE
- SECTION LINE
- - - QUARTER-QUARTER LINE
- DLC LINES (NOT SHOWN)
- ▨ NURSERY CROPS
- ▨ NORMAL IRRIGATION

RECEIVED

SEP 19 2017

OWRD

MAP BY:
ASPEN RURAL LAND CONSULTING

ERIC URSTADT, PE, PLS
971-250-1520
Mar 2017
Roofener1D1