


# T.2N.R.10E.W.M.

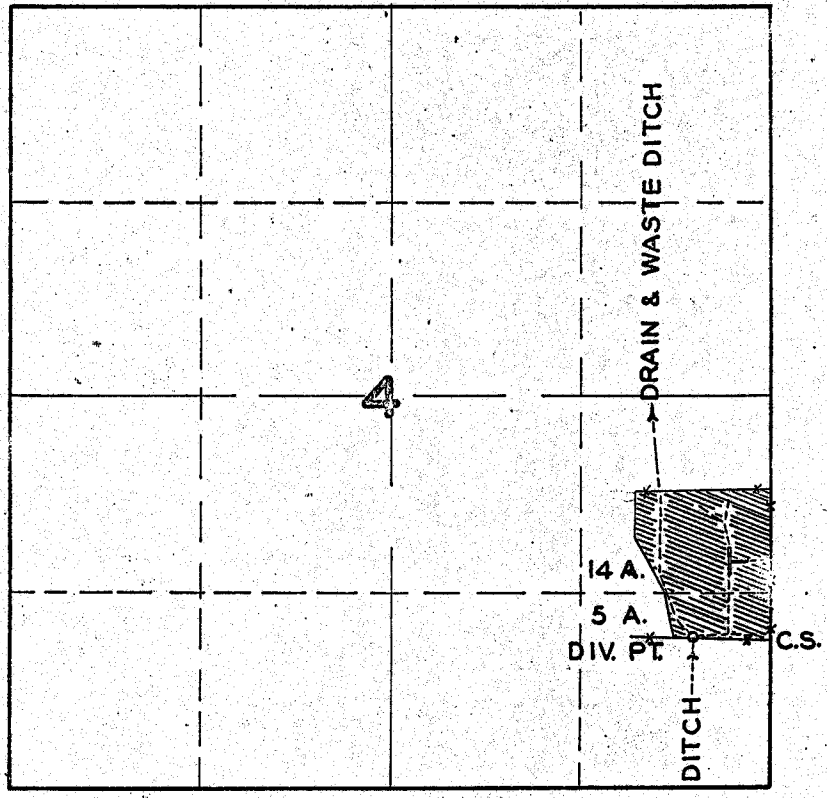

## FINAL PROOF SURVEY UNDER

Application No. 163.66 Permit No. 12.173  
IN NAME OF

H. A. BENDLER

Surveyed JUNE 15, 1950, by H.L. COFFMAN.