


T. 15S., R. 12E., W. M.

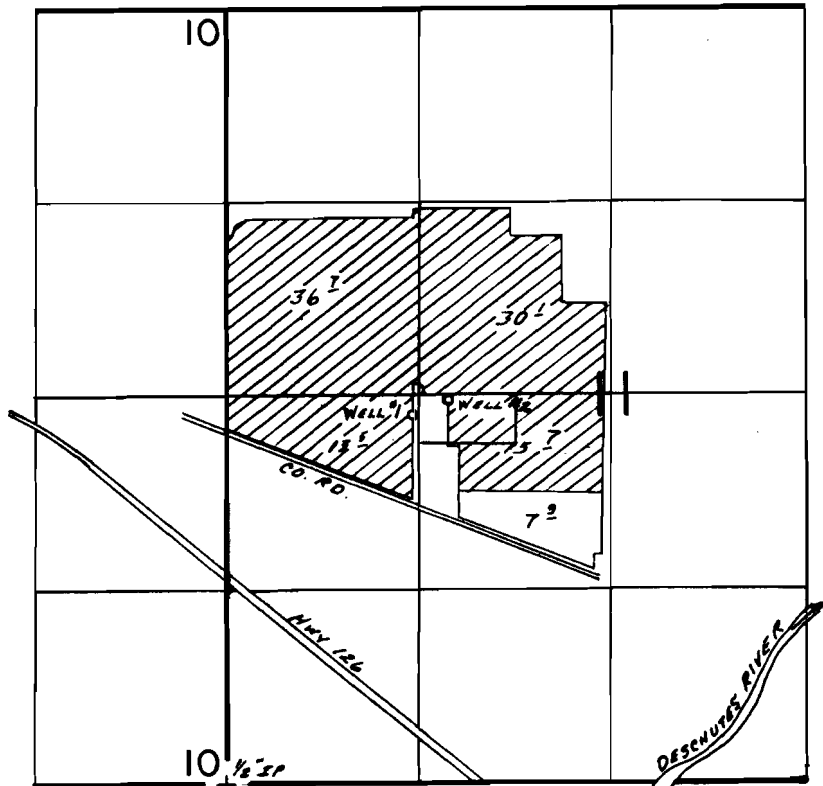

WELLS LOC.: #1-2500' N. & 1290' E.; #2-2610' N. & 1530' E., BOTH FROM SW COR. SEC. 11.

SCALE: 1" = 1320'

FINAL PROOF SURVEY UNDER

Application No. G-7840 Permit No. G-7275
IN NAME OF

JOHN WEISZ

Surveyed Oct. 11, 1988, by B.W. BISHOP

Cert: 60025
68255

RECEIVED

DATE 3-15-89


WATER MASTER DISTRICT #11

BY SWS

10/31/88


41017-179-T9R

G-7275

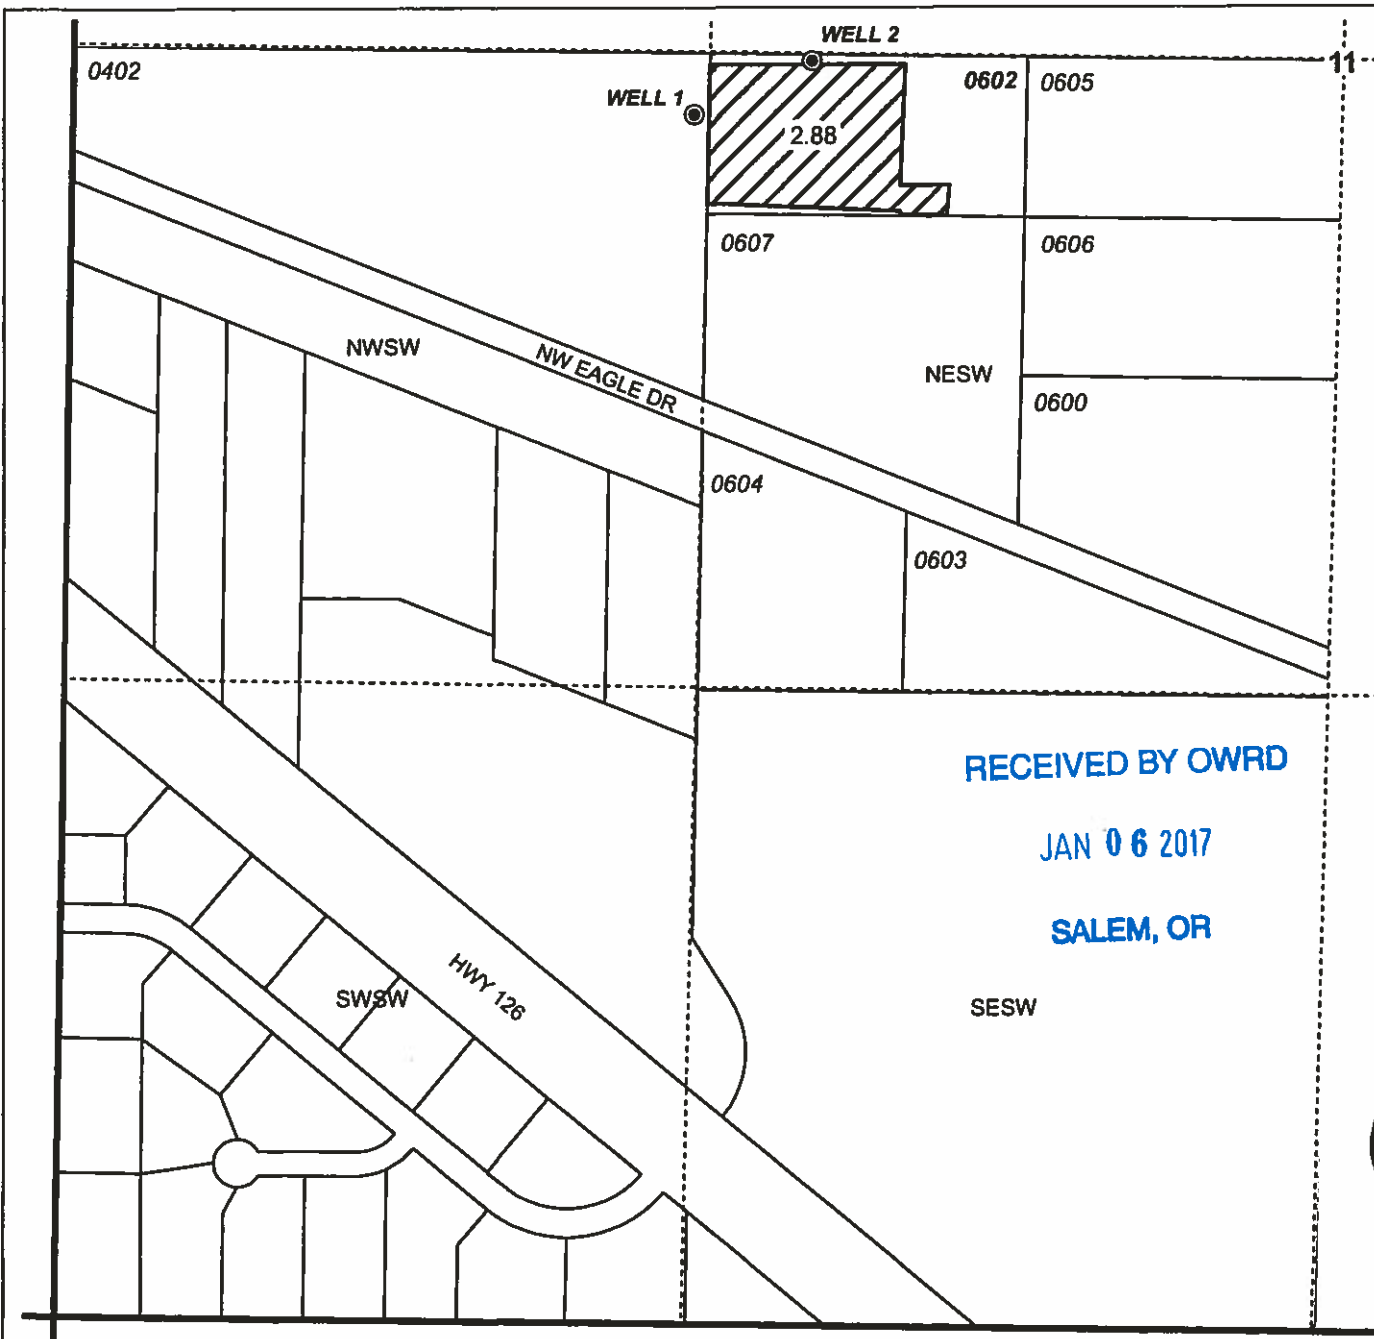

T15S, R12E, SECTION 11, WM

DESCHUTES COUNTY, OREGON

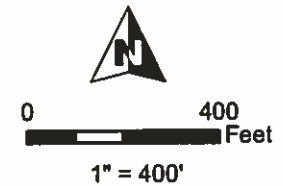


-  POU Irrigation, transfer ON
-  Section
-  Quarter Quarter
-  Tax Lot
-  Well

RECEIVED BY OWRD

JAN 06 2017

SALEM, OR

WELL LOCATIONS:
WELL 1: 2,500' N, 1,290' E OF SW COR SEC 11
WELL 2: 2,610' N, 1,530' E OF SW COR SEC 11

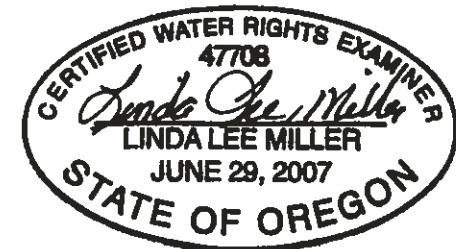

RENEWAL DATE 12/31/2018

TRANSFER "ON" MAP
Chulos

CERTIFICATE 68255

NOTE: THIS MAP IS NOT INTENDED TO
PROVIDE LEGAL DIMENSIONS OR LOCATIONS
OF PROPERTY OWNERSHIP LINES.

MAY 27, 2016

WATER RIGHT SERVICES, LLC
PO BOX 1830, BEND, OR 97709
CCB# 197121 www.oregonwater.us
541-389-2837 JOHNSHORT@USA.COM