


# T.10S., R.3W./4W., W.M.

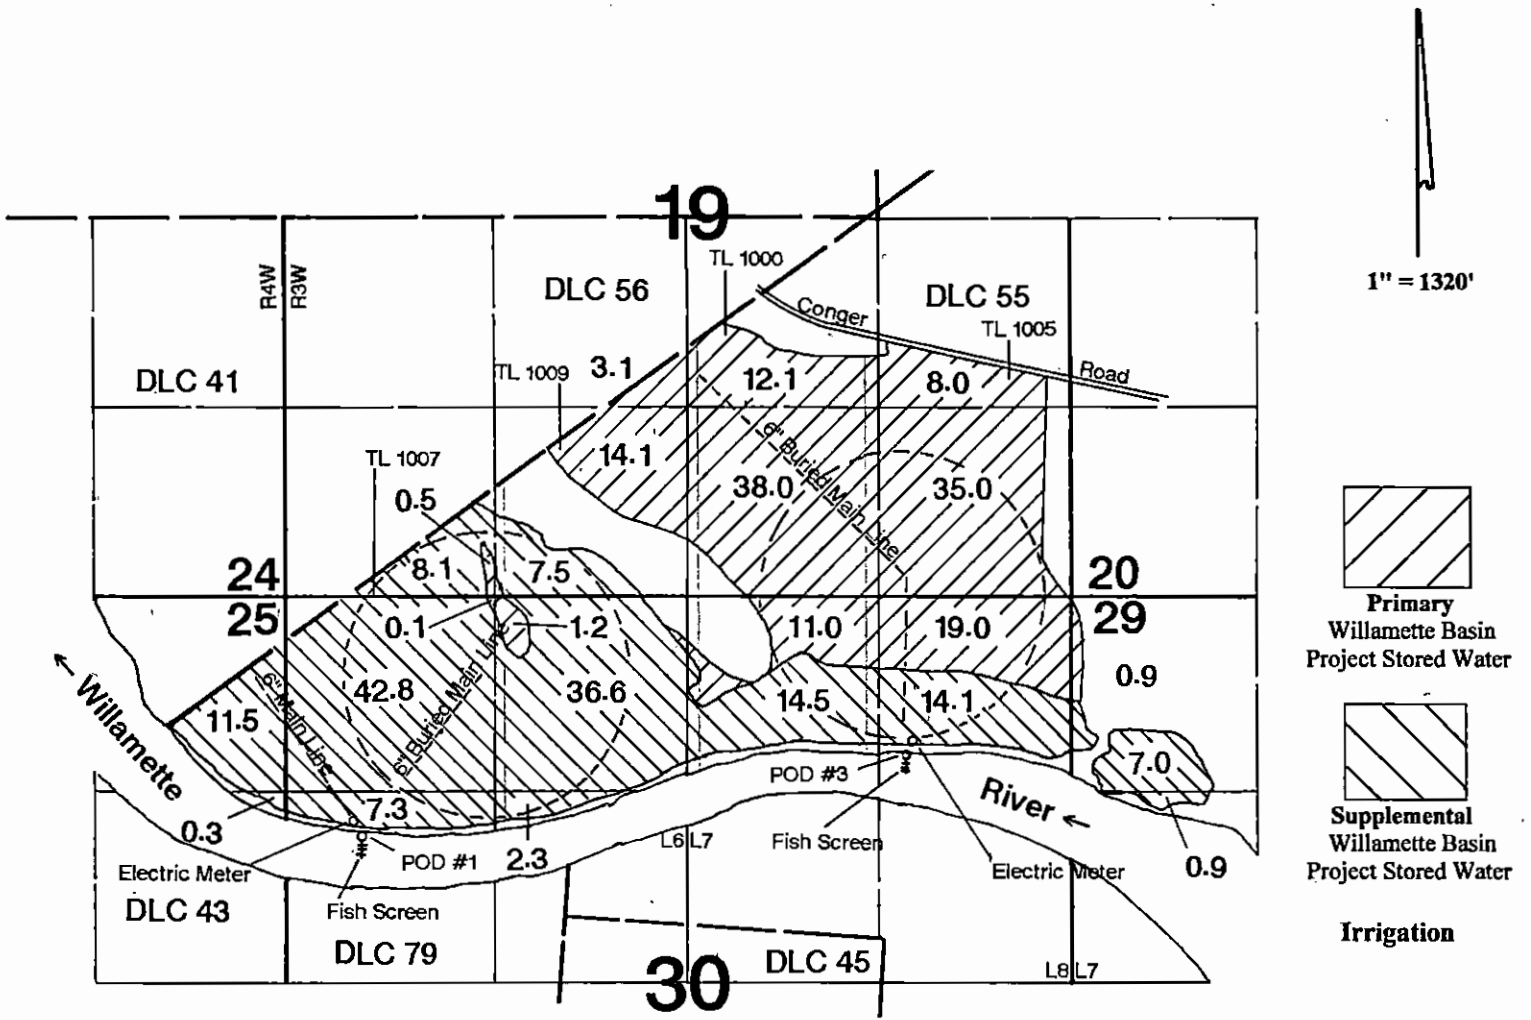

POD #1 is located S 58° 15' W 42.5 chains from N1/4 corner Section 30.  
 POD #3 is located S 58° 0' E 25.5 chains from N1/4 corner Section 30.

## Final Proof Survey

In the Name of

# Gray Farms Inc.

Application #: S-73275      Permit #: 53400


Surveyed on January 6, 2014 by JM Schuette

# RECEIVED

FEB 18 2014

WATER RESOURCES DEPT  
 SALEM, OREGON

This Map was Prepared for the Purpose of Identifying the Location of a Water Right Only and is Not Intended to Provide Legal Dimensions or Location of Property Ownership Lines.

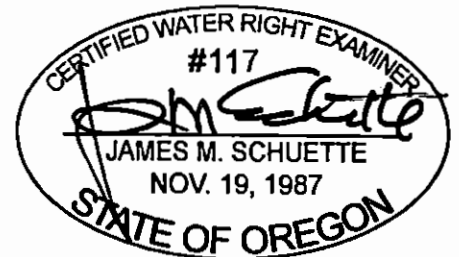

EXPIRES: 6/30/2014