


**CLAIM OF BENEFICIAL USE**  
**FOR GEORGE ACOSTA**  
**BY DUANE W. KIRBY**  
**T26S, R3W, WM., SEC 10**  
**APPLICATION NO S-87285**  
**PERMIT NO S-54590**  
**TAX LOT NO 200,300,400**  
**FISH SCREEN IS LOCATED AT THE POD**  
**METER IS LOCATED BY THE STORAGE TANK**

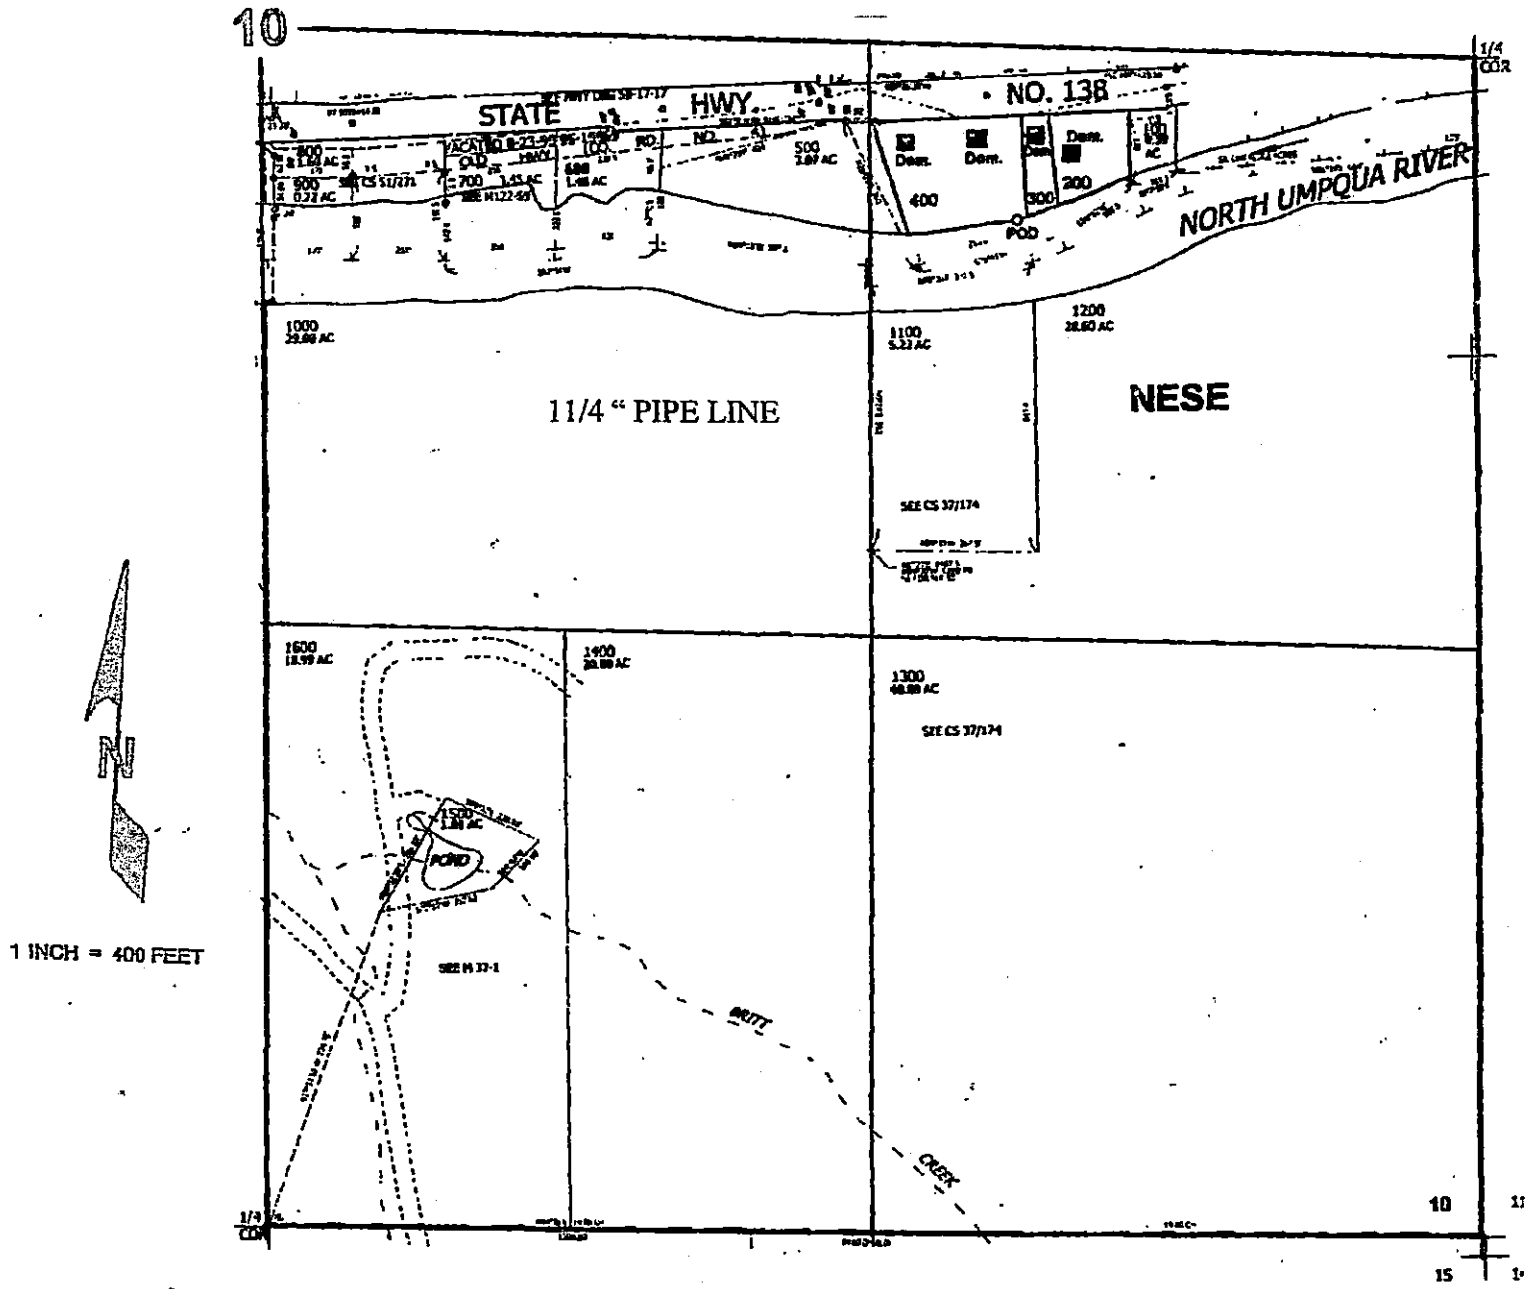

**POD is located 350 ft. S. and 980 ft. W. from the E 1/4 corner of Sec. 10**

THE PURPOSE OF THIS MAP IS TO  
 IDENTIFY THE LOCATION OF THE  
 WATER RIGHT. IT IS NOT INTENDED  
 TO PROVIDE INFORMATION RELATIVE  
 TO THE LOCATION OF PROPERTY  
 OWNERSHIP BOUNDARY LINES.

