


CLAIM OF BENEFICIAL USE  
 FOR DOUGLAS E, JOHNSON  
 BY DUANE W. KIRBY  
 T29S, R7W, SEC 8 TAX LOT 1300  
 APPLICATION NO S-83960  
 PERMIT NO S-53572  
 DOUGLAS COUNTY  
 FISH SCREEN IS AT THE POD  
 SCALE 1" = 400'

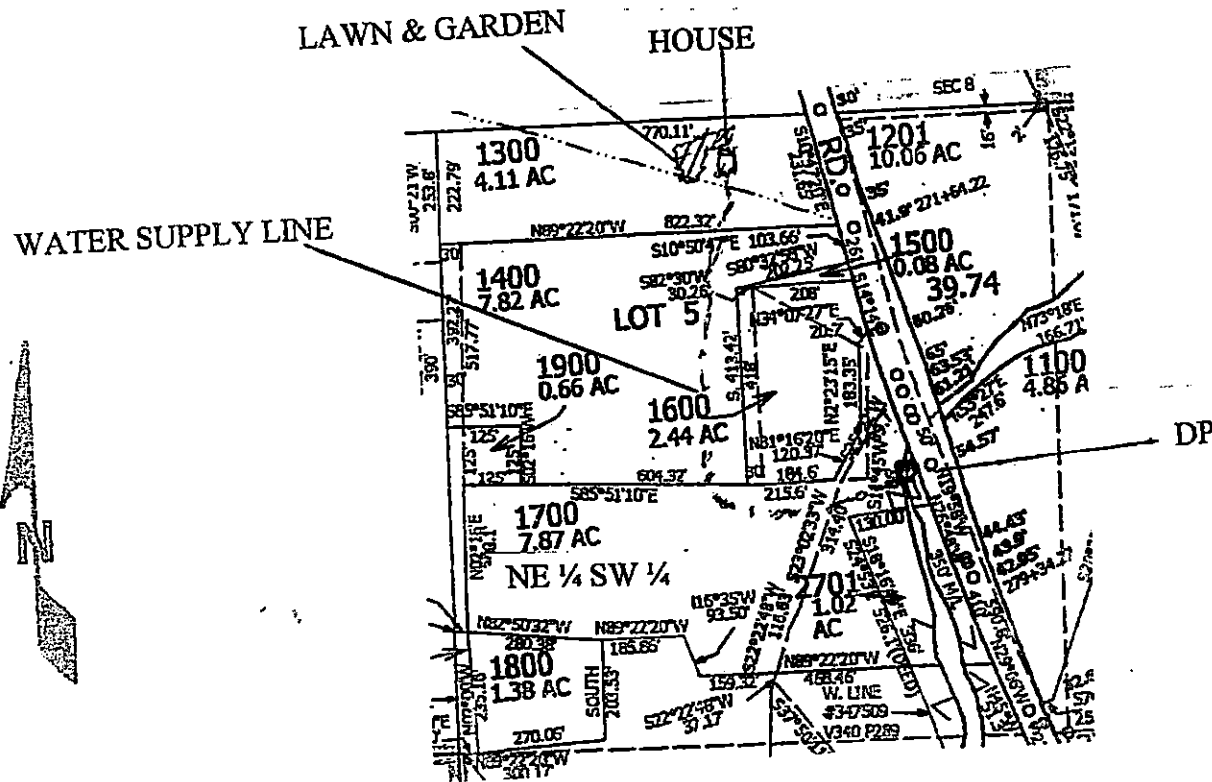

POD IS LOCATED 1830' N & 340' W OF  
 SOUTH 1/4 CORNER, SEC 8

THE PURPOSE OF THIS MAP IS TO  
 IDENTIFY THE LOCATION OF THE  
 WATER RIGHT. IT IS NOT INTENDED  
 TO PROVIDE INFORMATION RELATIVE  
 TO THE LOCATION OF PROPERTY  
 OWNERSHIP BOUNDARY LINES.

