



T. 13 S., R. 5 W., W. M.

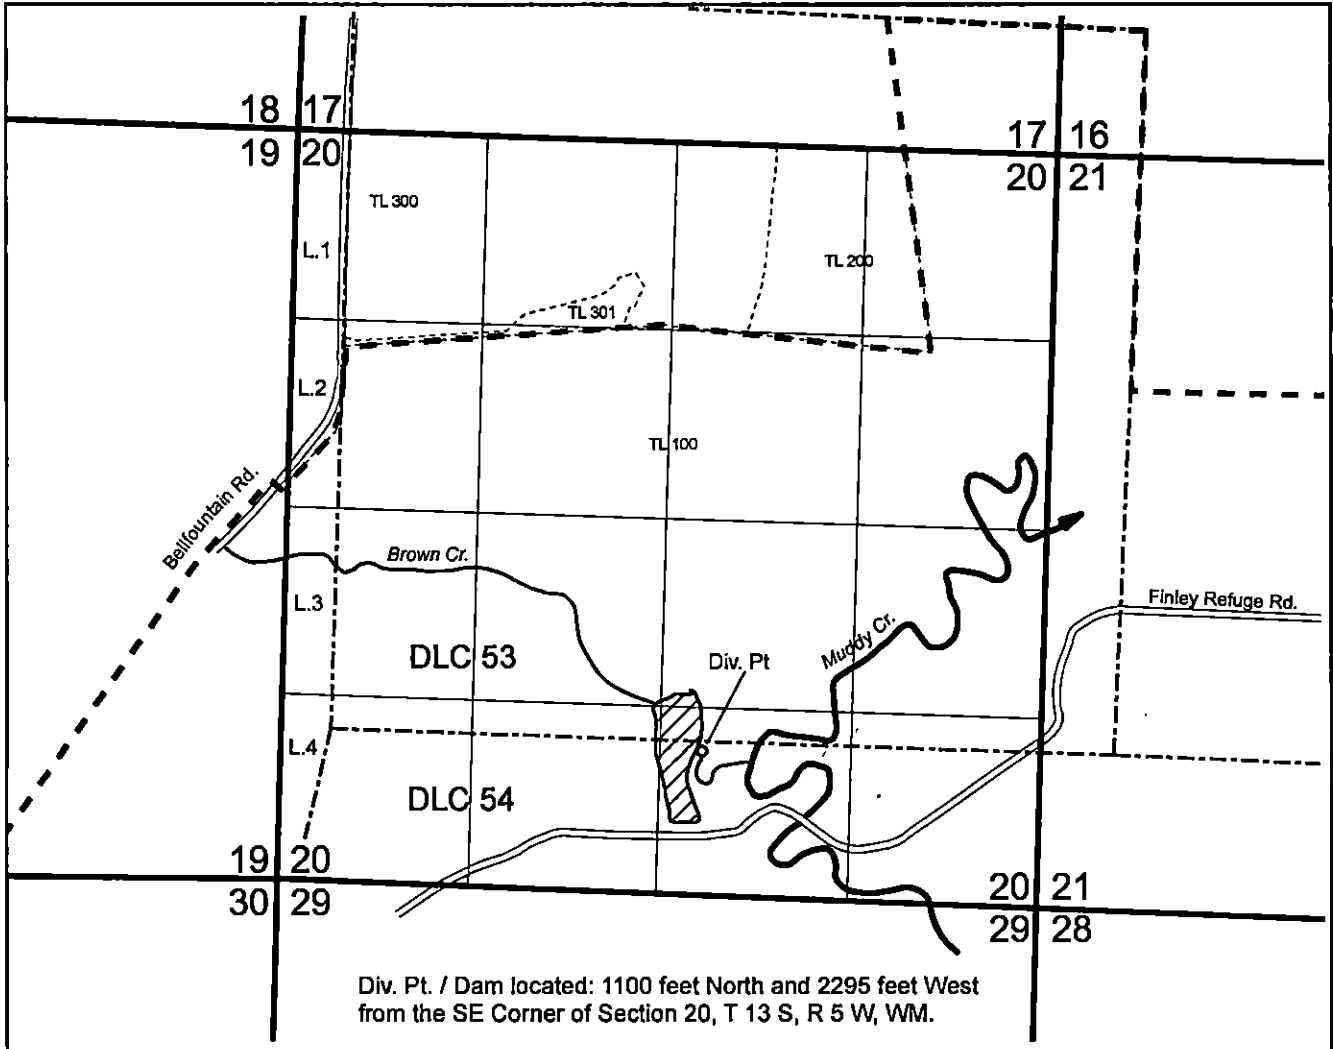


Div. Pt. / Dam located: 1100 feet North and 2295 feet West from the SE Corner of Section 20, T 13 S, R 5 W, WM.

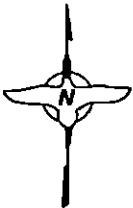

MAP TO ACCOMPANY CLAIM OF BENEFICIAL USE FOR APPLN R-86032, PER R-14063 IN THE NAME OF THE U.S.FISH & WILDLIFE SERVICE, WM. FINLEY NATIONAL WILDLIFE REFUGE

OREGON STATE PLANE GRID NORTH
(NORTH ZONE, $\theta = -2^{\circ} 00' 08.2''$)
1 INCH = 1320 FEET

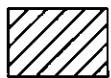

Field 16 Pond Place of Use




DLC Line




Refuge Boundary Line



1/4-1/4 or Gov't Lot Line

 

Tax Lot Line

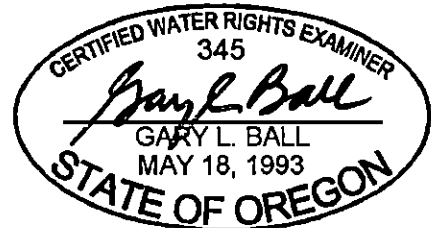

RENEWS: 12/31/2013

This map is not intended to provide legal dimensions or locations of property ownership lines.