


Section 14, T.4S, R.1E, W.M.  
Section 23, T.4S, R.1E, W.M.

CLACKAMAS COUNTY, OREGON




The well (Clack 12492) is 110 feet North and 1,940 feet East of the SW corner of Section 14.

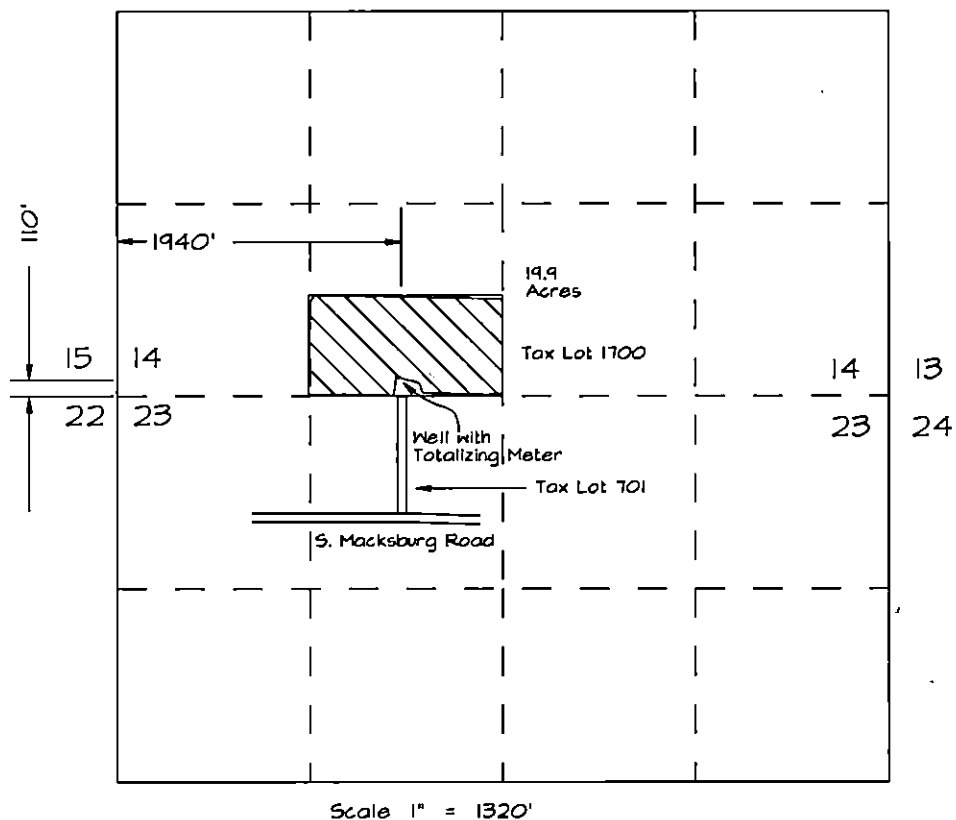

Irrigated Area  
(19.9 acres)

CLAIM OF BENEFICIAL USE MAP  
FOR  
ROGER and ANN SKOE

APPLICATION NO. G-16825 PERMIT NO. G-16346

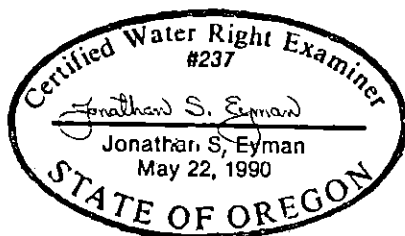

**RECEIVED**

NOV 27 2013

WATER RESOURCES DEPT  
SALEM, OREGON

THE PREPARATION OF THIS MAP IS FOR THE PURPOSE OF IDENTIFYING THE LOCATION OF THE WATER RIGHT ONLY AND HAS NO INTENT TO PROVIDE DIMENSIONS OR LOCATION OF PROPERTY OWNERSHIP LINES.

10/05/2013