




# CLAIM OF BENEFICIAL USE MAP

## Section 14, T.39S. R.18E., W.M.

Lake County, Oregon

Application No. S-87725 Permit No. S-54763

*Perry Parmelee*

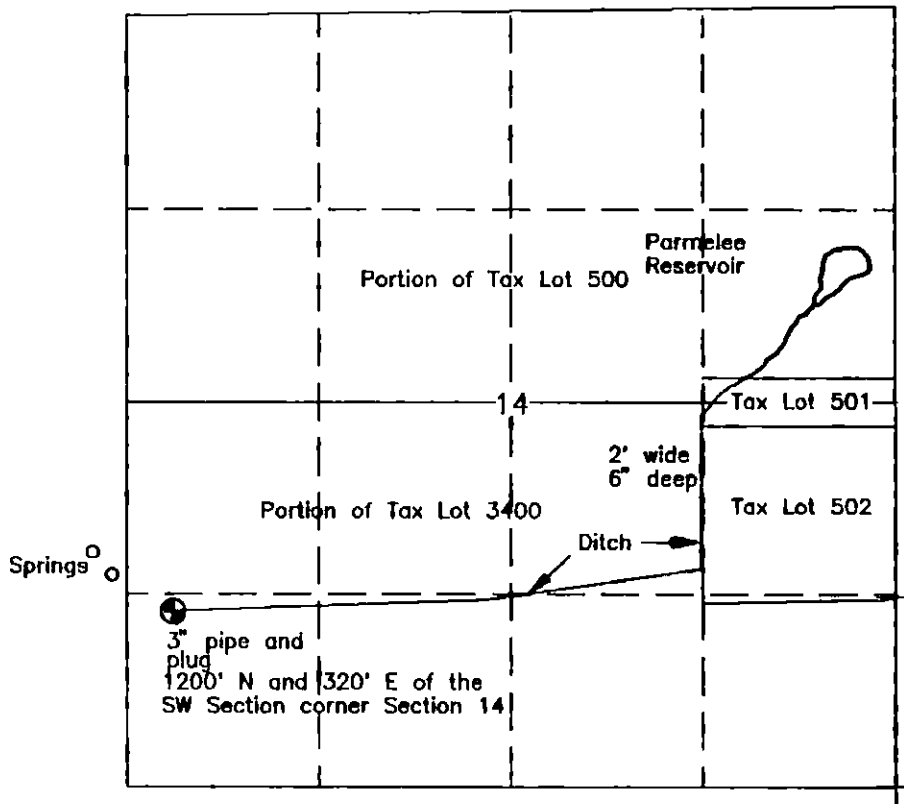


RECEIVED BY OWARD

SEP 08 2014

SALEM, OR

Survey By: Sundet & Associates  
PO Box 1228  
Lakeview, OR 97630  
541-947-4458  
Drawing #1403 July 2014

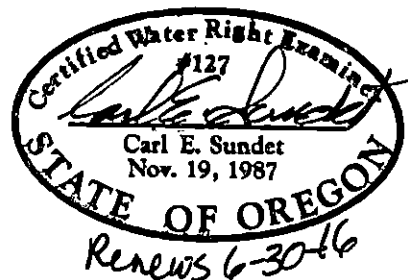

This map is not intended to provide legal dimensions or location of property ownership lines.