

FINAL PROOF SURVEY
AND
CLAIM OF BENEFICIAL USE

LOCATED WITHIN
NE 1/4, SE 1/4 AND SE 1/4, SE 1/4,
SECTION 22, T.2N., R.32E., W.M.,
UMATILLA COUNTY, OREGON
APPLICANTS: MARK E. AND TINA J. CAVE

TRANSFER 9471

SPECIAL ORDER VOLUME 59, PAGE 121

LEGEND

----- BURIED 2" PVC DISTIRIBUTION LINE

• 2" RISER

⊕ WELL

⊗ SECTION CORNER

----- SECTION LINE

----- 1/16TH LINE

▨ AREA BENEFICIALLY IRRIGATED

NE 1/4, SE 1/4	1.98 ACRES
SE 1/4, SE 1/4	0.77 ACRES
TOTAL	2.75 ACRES

CORNER TIE

WELL IS LOCATED 1,340
FEET NORTH AND 35 FEET
WEST OF SE CORNER OF
SECTION 22.


RECEIVED

DEC 30 2004

**WATER RESOURCES DEPT
SALEM, OREGON**


N

400' 0' 400'
1"=400'

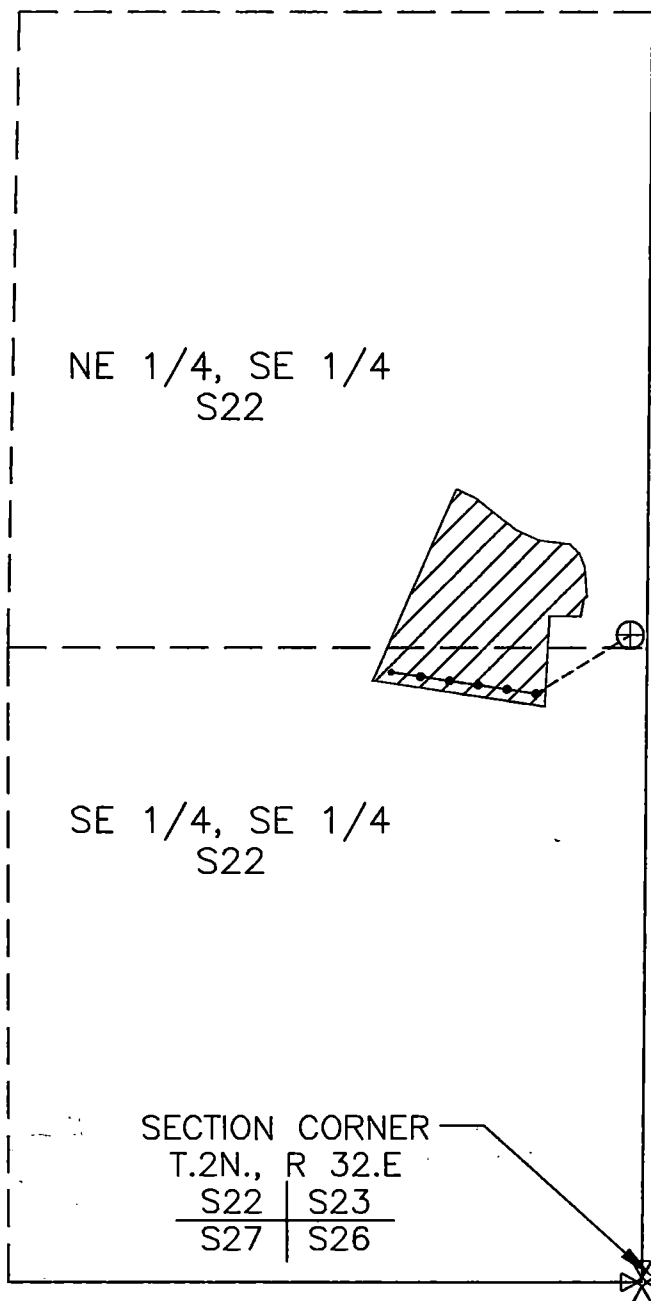

THIS MAP IS PREPARED
FOR THE EXPRESS
PURPOSE TO SHOW WATER
APPROPRIATION AND USE.
IT IS NOT INTENDED TO
SHOW OR LOCATE
PROPERTY OWNERSHIP
LINES.

©

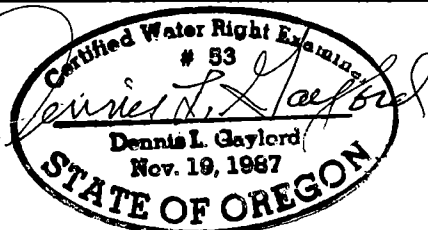

Rehears 6/30/2005

DENNIS L. GAYLORD,
CWRE
71614 S.W. LAKE DRIVE
PENDLETON, OR 97801
(541)-276-6260
NOVEMBER, 2004

Mill Creek Drafting