


Application No. G-11419  
Permit No.

**RECEIVED**  
JAN 29 1986  
WATER RESOURCES DEPT  
SALEM, OREGON

T. 4S., R. 1W., W.M.

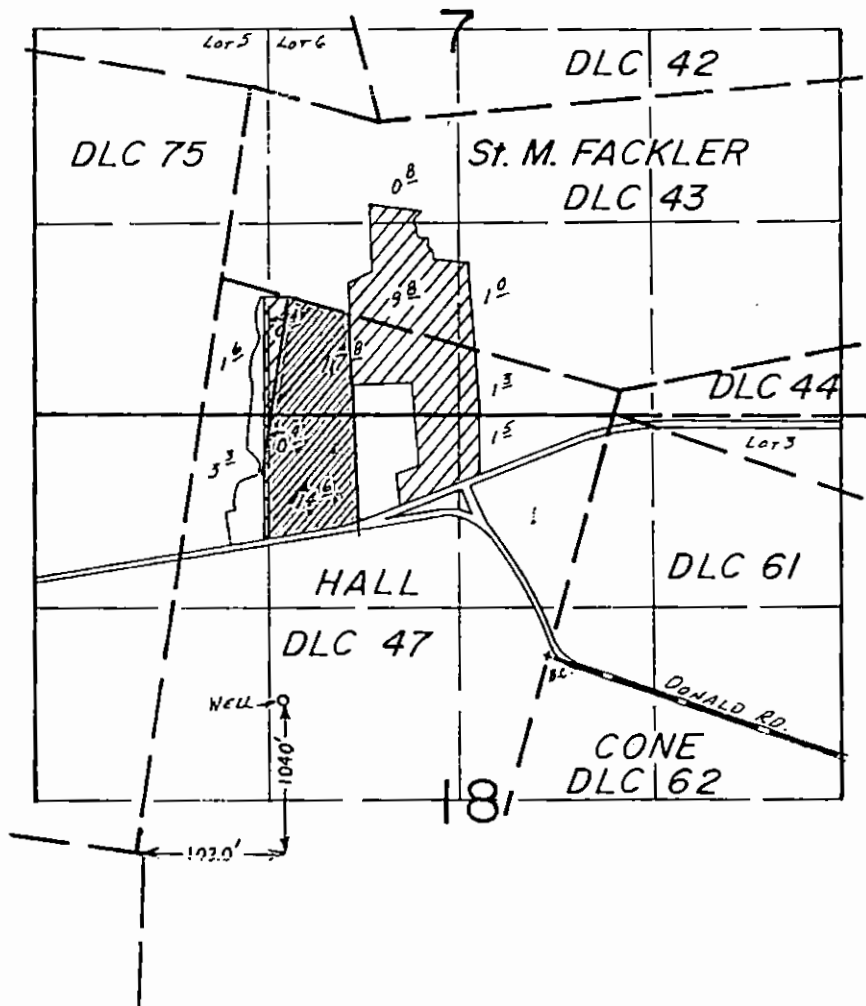

**FINAL PROOF SURVEY**  
UNDER

Application No. G-7860. Permit No. G-8165.....  
IN NAME OF

.....FRANCIS X. RYAN.....

Surveyed OCT. 4.... 1983., by L.M. TOLL.....