
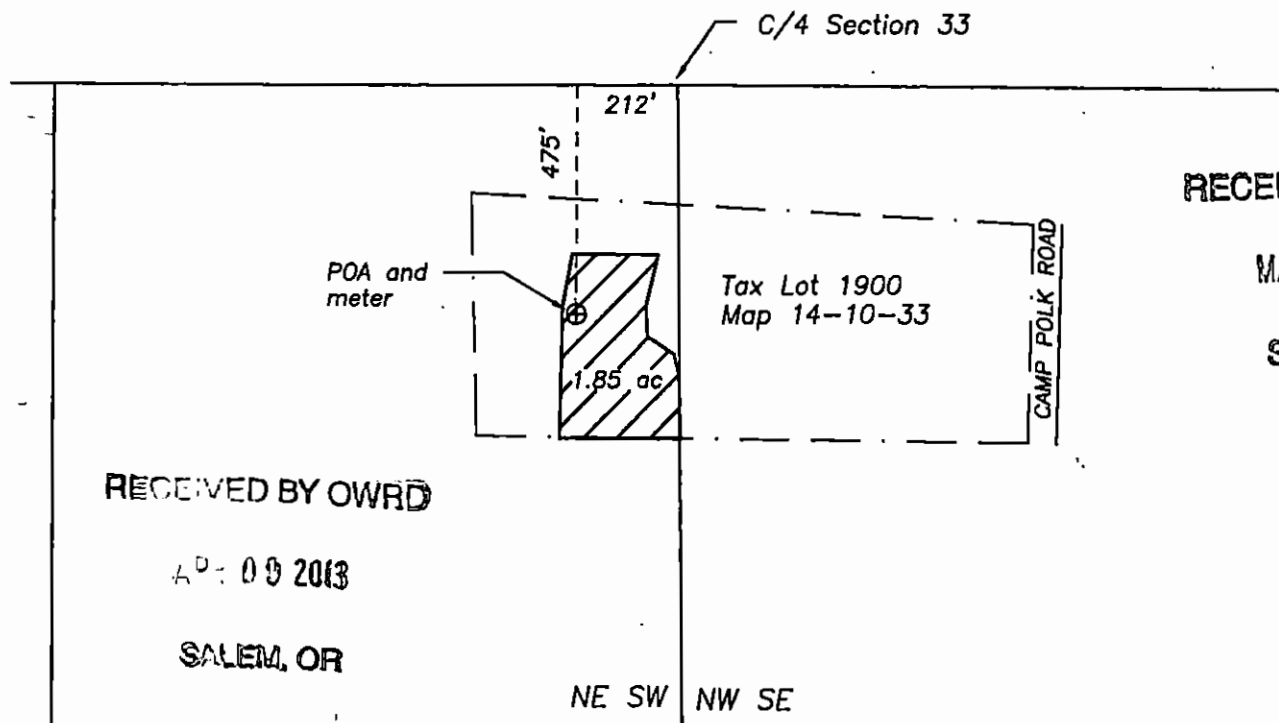


Claim of Beneficial Use

Application G-12651, Permit G-12398
Deschutes County, Oregon

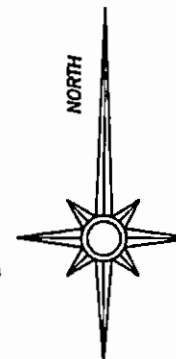

RECEIVED BY OWRD

MAR 22 2013

SALEM, OR

RECEIVED BY OWRD


APR 09 2013

SALEM, OR



Renewal date: 6/30/2014

Section 33
T14S, R10E, W.M.
Deschutes Co., OR

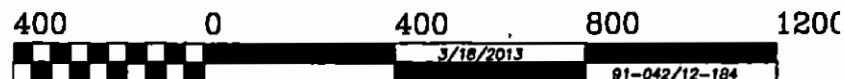

GRAPHIC SCALE - FEET




Place of beneficial use, Permit
G-12398, priority date 9/9/1997.



Tax lot boundary



Well and meter

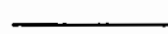

1/16 Section lines

THIS MAP IS FOR THE PURPOSE OF IDENTIFYING THE LOCATION OF
THE WATER RIGHT. IT IS NOT INTENDED TO PROVIDE LEGAL
DIMENSIONS OR LOCATIONS OF PROPERTY OWNERSHIP LINES.