


0581

FINAL PROOF MAP

TO ADD POINTS OF DIVERSION
FOR PERMITS S-53755 & R-13102
FRED HANSON

SECTIONS 3, 4, & 9, TOWNSHIP 10 SOUTH, RANGE 29 EAST, W.M.
TAX LOT: 800
ALL IN GRANT COUNTY, OREGON

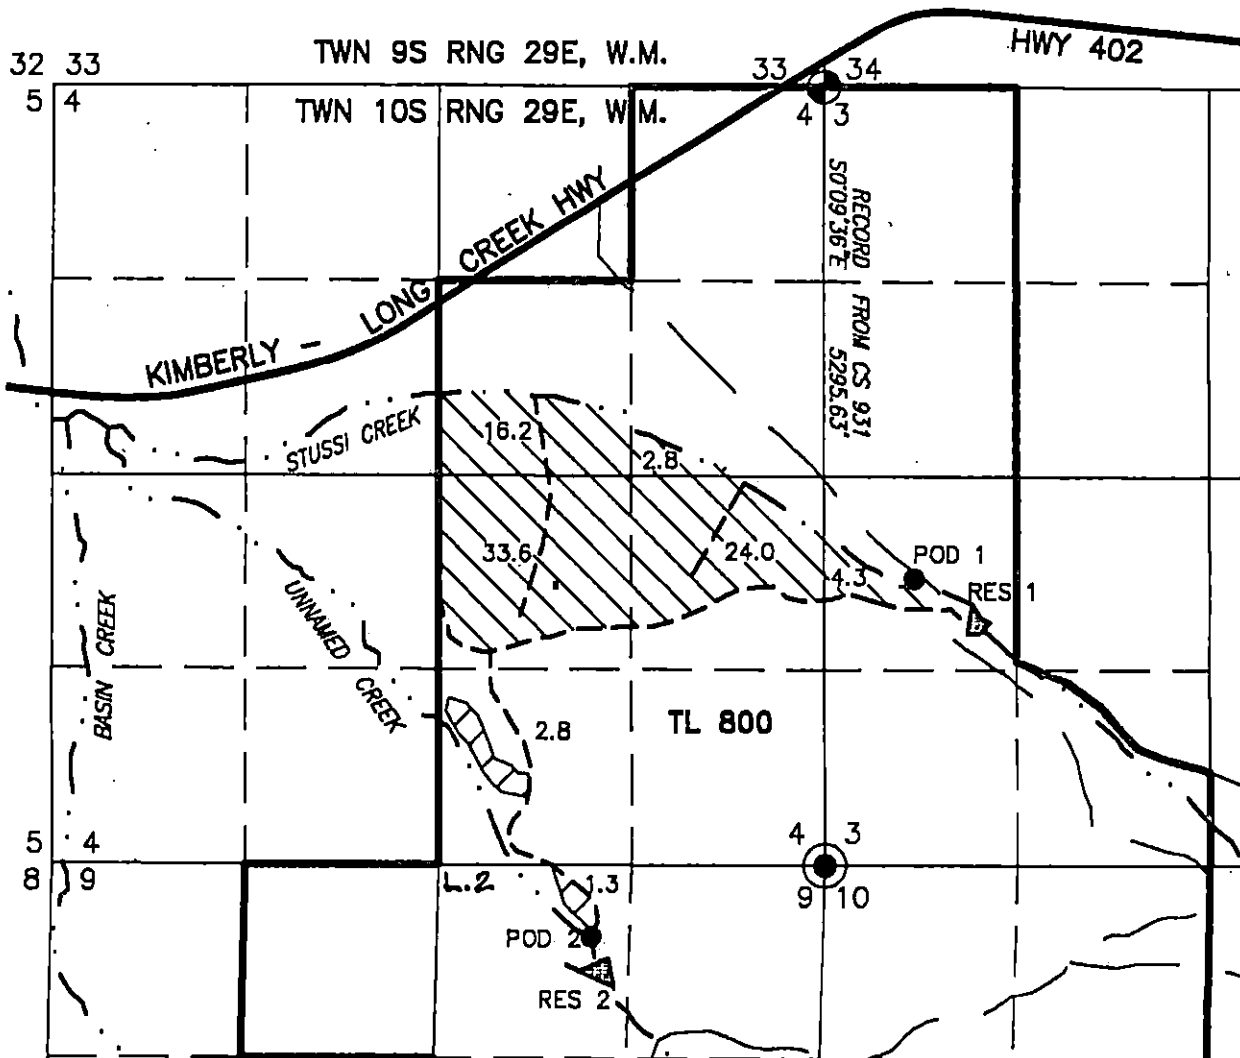

RECEIVED

APR 26 2011

WATER RESOURCES DEPT
SALEM, OREGON

- **POD 1**
LOCATED IN THE NW 1/4 SW 1/4 SECTION 3
REFERENCED 614 FEET EAST AND 1944 FEET NORTH
FROM THE SW CORNER OF SECTION 3.
- **POD 2**
LOCATED IN THE NW 1/4 NE 1/4 SECTION 9
REFERENCED 1608 FEET WEST AND 489 FEET SOUTH
FROM THE NE CORNER OF SECTION 9.

RES 1

LOCATED IN THE NW 1/4 SW 1/4 SECTION 3
OUTLET IS 932 FEET EAST AND 1679 FEET NORTH
FROM THE SW CORNER OF SECTION 3.
SPILLWAY IS 1016 FEET EAST AND 1770 FEET NORTH
FROM THE SW CORNER OF SECTION 3.


RES 2

LOCATED IN THE NW 1/4 NE 1/4 SECTION 9
OUTLET IS 1577 FEET WEST AND 628 FEET SOUTH
FROM THE NE CORNER OF SECTION 9.
SPILLWAY IS 1688 FEET WEST AND 728 FEET SOUTH
FROM THE NE CORNER OF SECTION 9.


● CORNER POSITION COMPUTED PER CS 931.

● 2-1/2 INCH ALUMINUM CAP PER CS 931.


--- STREAM
--- CANAL
--- JEEP TRAIL
--- HIGHWAY

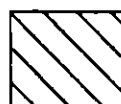

75.6 ACRES FROM POD 1 AND RES 1
(S-53755 AND R-13102), AS SHOWN.

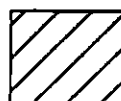

9.4 ACRES FROM POD 2 AND RES 2
(S-53755 AND R-13102), AS SHOWN.

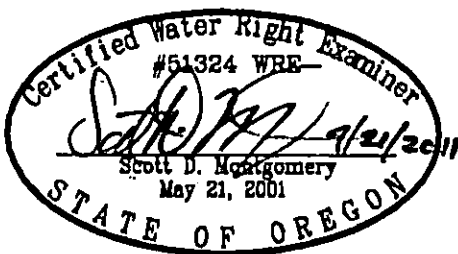

RENEWAL: 12/31/2012

THIS MAP IS FOR THE PURPOSE OF
LOCATING A WATER RIGHT ONLY
AND HAS NO INTENT TO PROVIDE
LEGAL DIMENSIONS OR THE
LOCATION OF PROPERTY LINES

PREPARED FOR:

FRED HANSON
710 S. FAIRVIEW STREET
PRINEVILLE, OR 97754

map amended by WRO to include

PREPARED BY:



ALL POINTS ENGINEERING AND SURVEYING, INC.
P.O. BOX 767 (CRR) TERREBONNE, OR 97760
(541) 548-5833 www.APEandS.com

NONE G. LOT 2 Sec. 9. Joyce/WRO 11-18-10