

T. 34 S. R. 1 W. W.M.

RECEIVED

SEP 30 1996

WATER RESOURCES DEPT.
SALEM, OREGON

SW 1/4 of SW 1/4

SE 1/4 of SW 1/4

Jackson County Surveyor
brass cap monument 1968

4 3
9 10

NW 1/4 of NW 1/4

NE 1/4 of NW 1/4

2.34 AC.

Found 5/8 rebar
and plastic cap
Survey 12319

N 00°04'11" W
860.00'
Basis of bearings per Filed
Survey No. 12319

1.09 AC.

0.69 AC.

2" Plastic pipe
1.20 AC.

Storage
Pond

0.45 AC.

0.30 AC.

1" and 1 1/4"
plastic pipe

Found 5/8 rebar
no cap per Survey
12319

Point of diversion
1219' South and 2510'
East of NW corner
Section 10

Crater Lake Hwy. 62

Rogue River

2.60 AC.

SW 1/4 of NW 1/4

SE 1/4 of NW 1/4



Scale 1" = 400'

FINAL PROOF SURVEY


APPLICATION NO. 71362

PERMIT NO. 51249

in the name of

John RG Blake

Survey by: Timberline KKB Land Surveying
Kerry K. Bradshaw LS 2271 CWRE 233
P.O. Box 3064
Central Point, Or. 97502
(503)664-7510 (503)944-6692

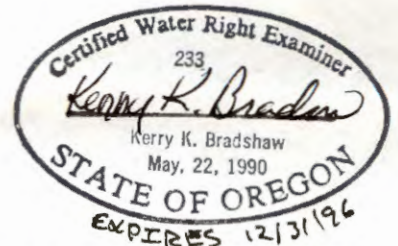

SEPTEMBER 26, 1996