


TOWNSHIP 17 SOUTH, RANGE 23 EAST, W.M.

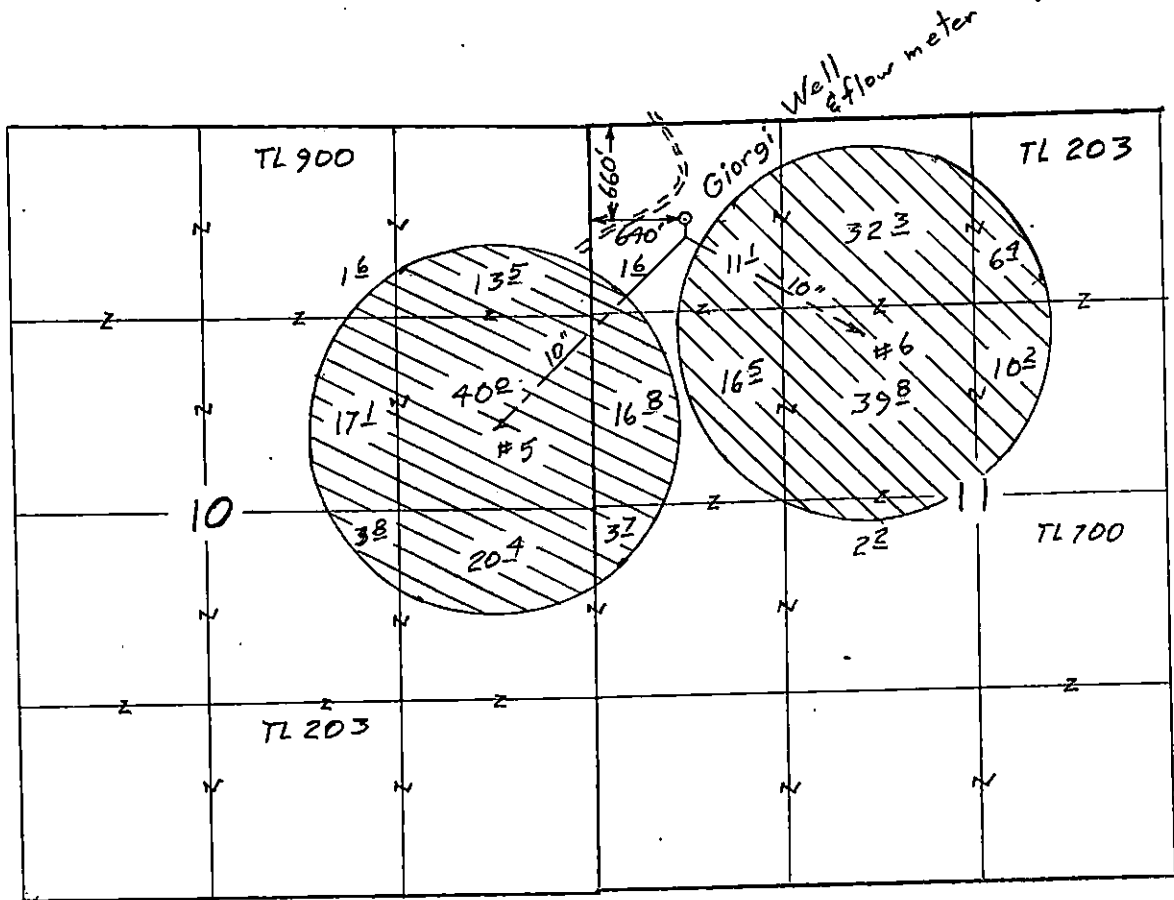

⊙ #5 118± acres

⊙ #6 118± acres

Surveyed Aug. 24, 2012

Claim of Beneficial Use Map
for

JOHN GIORGI

RECEIVED BY OWRD

RECEIVED BY OWRD


JAN 14 2013

FEB 04 2013

SALEM, OR

SALEM, OR

App G-16214
Per G-15811
T-9876

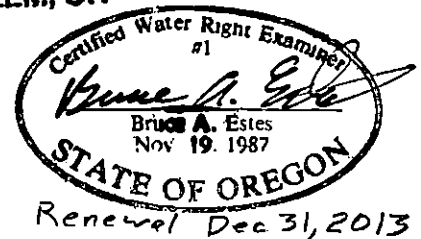

This map is for the purpose of locating a water right only and has no intent to provide legal dimensions or the location of property lines.

ESTES SURVEYS, LLC

PO Box 17519
Salem, OR 97305-7519
(503) 586-7599

60382 Arnold Rd
Bend, OR 97702
(541) 382-7391