

Cobu MAP 920


T.11S., R.35E., W.M.

FINAL PROOF SURVEY
UNDER
APPLICATION S-72120
PERMIT 54166

IN NAME OF
**OREGON PARKS AND
RECREATION DEPARTMENT**

PREPARED BY:
ROBERT D. BAGETT
217 N. CANYON BLVD.
JOHN DAY, OREGON
(541) 575-1251

DATE SURVEYED: NOVEMBER 6, 2014

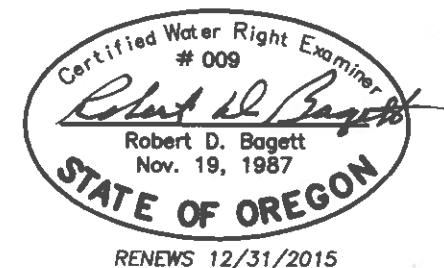

RECEIVED BY OWRD

JUL 06 2015

SALEM, OR

SCALE: 1" = 400'

(600)
SE1/4SE1/4

SW1/4SW1/4
(600)

COUNTY ROAD 20

20 21

29 28

SPILLWAY &
FISH LADDER

OUTLET
TRENCH

OUTLET PIPE &
CONTROL WORKS

DAM

(600)
NW1/4NW1/4

(600)
E1/2NE1/4NE1/4

(600)
SW1/4NW1/4

(600)
SE1/4NW1/4

NE1/4NW1/4

(600)

STATE HWY 7

○ MIDDLE CENTERLINE OF DAM IS 580 FT. SOUTH &
70 FT. EAST FROM THE NW CORNER SECTION 28.

■ #1 MEASURING DEVICE #1: WEIR, IS 1000 FT. SOUTH
AND 600 FT. EAST FROM MIDDLE CENTERLINE OF
DAM

■ #2 MEASURING DEVICE #2: WEIR, AT NORTH END OF
FISH LADDER BY SPILLWAY IS 70 FT. NORTH AND
200 FT. WEST FROM MIDDLE CENTERLINE OF DAM

△ MEASURING DEVICE #3: STAFF GAGE ON GATE
VALVE STRUCTURE IS 10 FT. NORTH AND 145 FT.
EAST FROM THE MIDDLE CENTERLINE OF DAM

▨ PLACE OF USE BATES RESERVOIR

() TAX LOT

● FOUND RECORD SURVEY MONUMENT: ALUMINUM CAP

THIS MAP IS NOT INTENDED TO PROVIDE LEGAL DIMENSIONS OR LOCATIONS
OF PROPERTY OWNERSHIP LINES.