

RECEIVED BY OWRD

JUN 13 2013

SALEM, OR


T.11S., R.35E., W.M.

FINAL PROOF SURVEY
UNDER
APPLICATION R-72107
PERMIT R-14139
IN NAME OF
OREGON PARKS AND
RECREATION DEPARTMENT

BY

ROBERT D. BAGETT
217 N. CANYON BLVD.
JOHN DAY, OREGON
(541) 575-1251

DATE SURVEYED: MAY 17, 2013

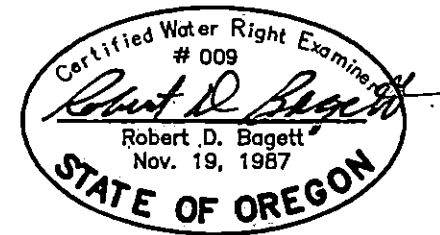

SCALE: 1" = 400'

- FOUND RECORD SURVEY MONUMENT: ALUMINUM CAP
- △ MEASURING DEVICE: STAFF GAGE ON GATE VALVE STRUCTURE IS 10 FT. NORTH AND 145 FT. EAST FROM THE MIDDLE CENTERLINE OF DAM
- MIDDLE CENTERLINE OF DAM IS 585 FT. SOUTH & 80 FT. EAST FROM THE NW CORNER SECTION 28.

▨ PLACE OF USE

() TAX LOT

COBU MAP #772

NOTE: THE PREPARATION OF THIS MAP WAS FOR THE PURPOSE OF IDENTIFYING THE LOCATION OF THE PROPOSED WATER RIGHT AND HAS NO INTENT TO PROVIDE DIMENSIONS OR LOCATION OF PROPERTY OWNERSHIP LINES.

