


Claim of Beneficial Use Permit G-16430 (Application G-16864)

A Water Right in the Name of Robert Stadeli
Tax Lot 071W10-01400, Marion County
Township 7 South, Range 1 West (W.M.)

File Path: P:\Portland\501-Robert Stadeli\001-Water Rights\Project_GIS\Project.mxd; COBU.mxd; Date: October 4, 2013 12:23:49 PM

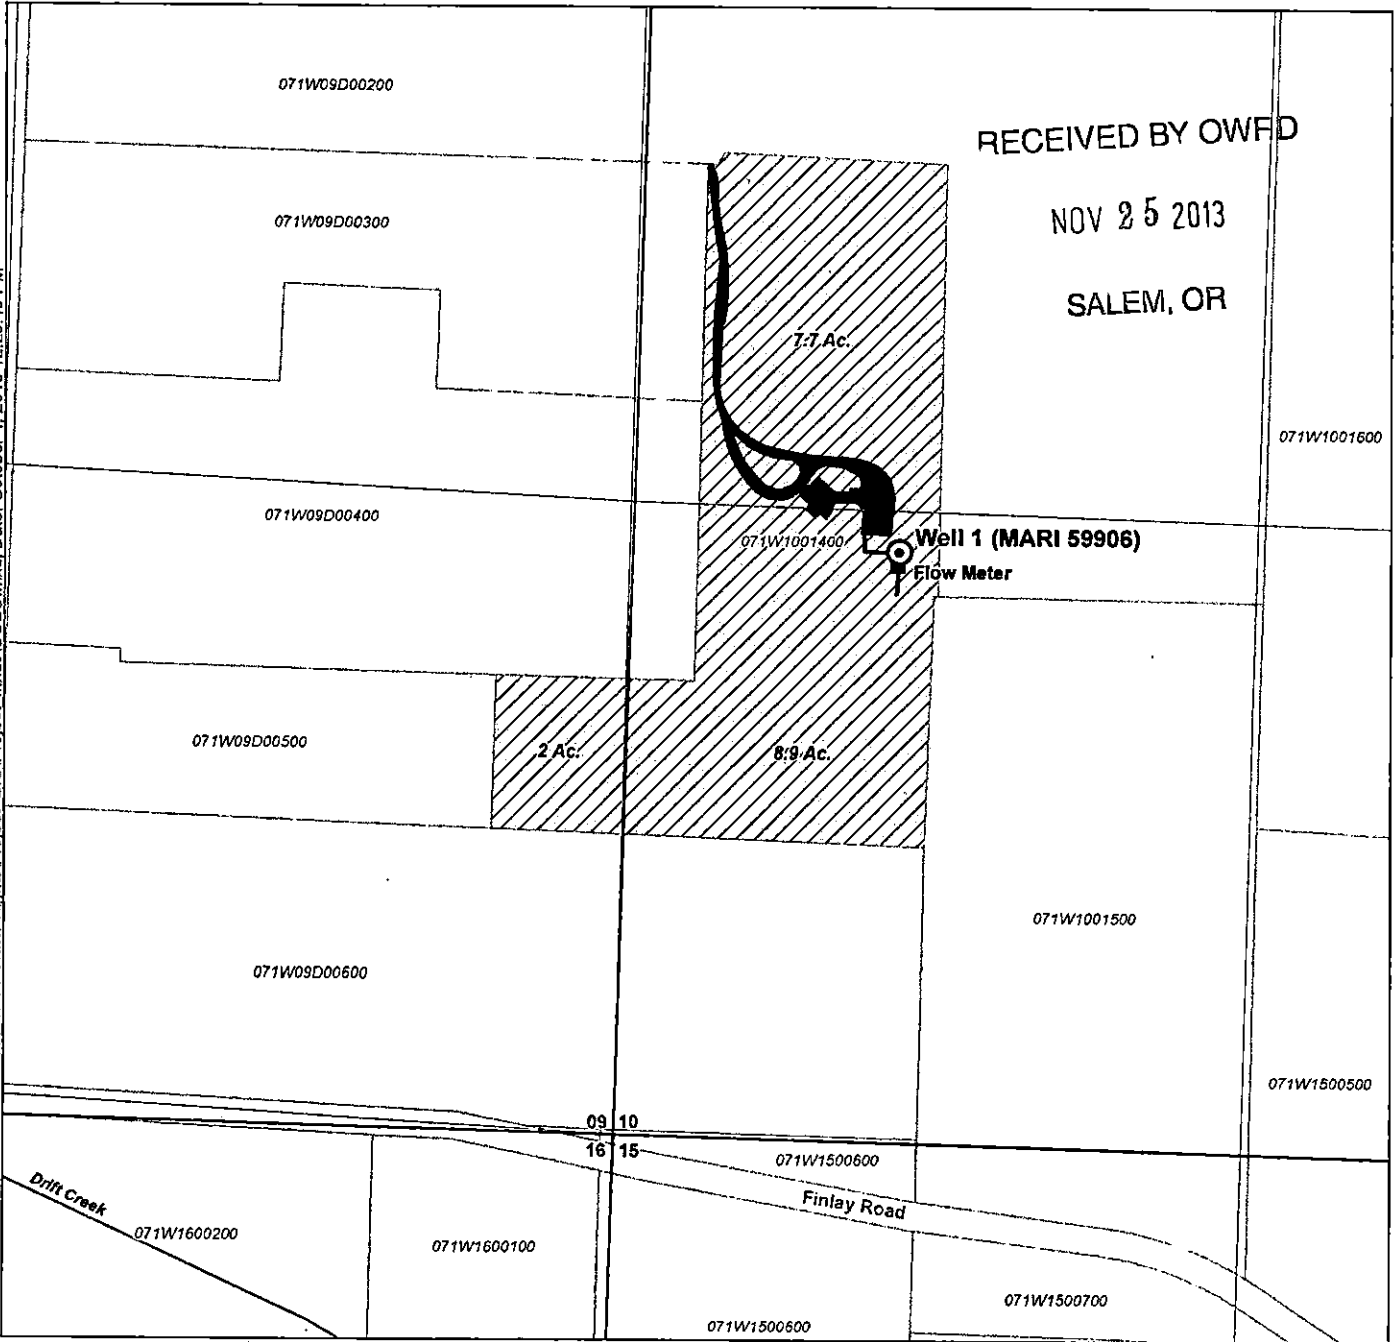


RECEIVED BY OWFD
NOV 25 2013
SALEM, OR

LEGEND

- Point of Appropriation
- Meter
- Place of Use
- Building
- Road/Driveway
- Water Mainline
- Tax Lot
- Watercourse

Certified Water Rights Examiner Stamp

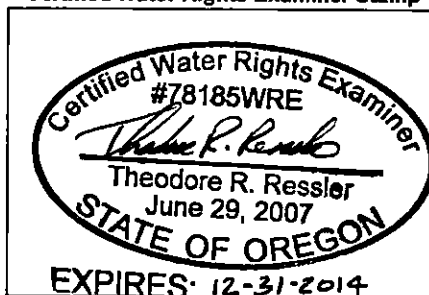

Disclaimer
This map was prepared for the purpose of identifying the location of a water right only and it is not intended to provide legal dimensions or location of property ownership lines.

Map Notes

Date: October 4, 2013
Data Sources: BLM, USGS, Marion County
Prepared By: GSI Water Solutions, Inc.

POA Location Description

Well 1 (MARI 59906)
Located 1250 feet North and 550 feet east from the SW corner of Section 10, Township 7 South, Range 1 West (W.M.)

