



EXHIBIT B

T31S, R33E, W.M.
Harney County, Oregon

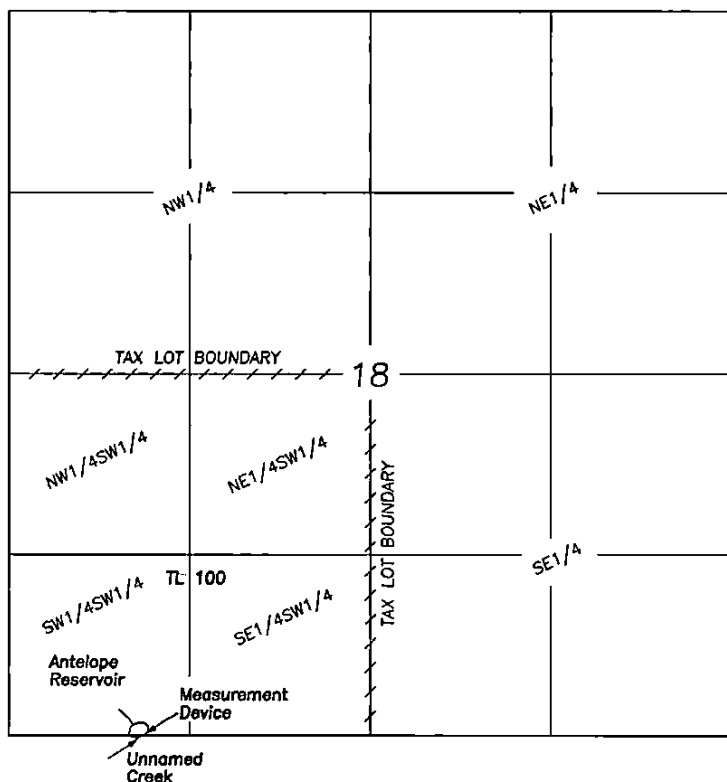

Outlet is located 70' North & 910' East of the SW corner of Section 18.

Measuring device is located 80' South and 10' East of the Outlet.

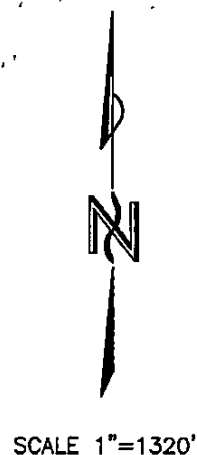

FINAL PROOF SURVEY
CLAIM OF BENEFICIAL USE
ANTELOPE RESERVOIR

For

Bureau of Land Management
July 12, 2017

LEGEND

Application No. R-34996
Permit No. R-4155
Priority 6/8/1961

--- Tax Lot Boundary

A portion of Tax Lot
31-33 TL100

NOTE: Tax Lot 100 is owned by the BLM and is more that 4,800 acres. Therefore only a portion of the tax lot boundary can be shown.

Prepared by
Cornerstone Surveying, Inc
P.O. BOX 33
JOHN DAY, OR. 97845
(541)575-1813
cornerstonesurvey@centurytel.net

RECEIVED BY OWRD

NOV 03 2017

SALEM, OR

NOTE: The preparation of this map was for the purpose of identifying the location of the proposed water right and has no intent to provide dimensions or location of property ownership lines.

