


T. 4 S. R. 1 W. W. M.

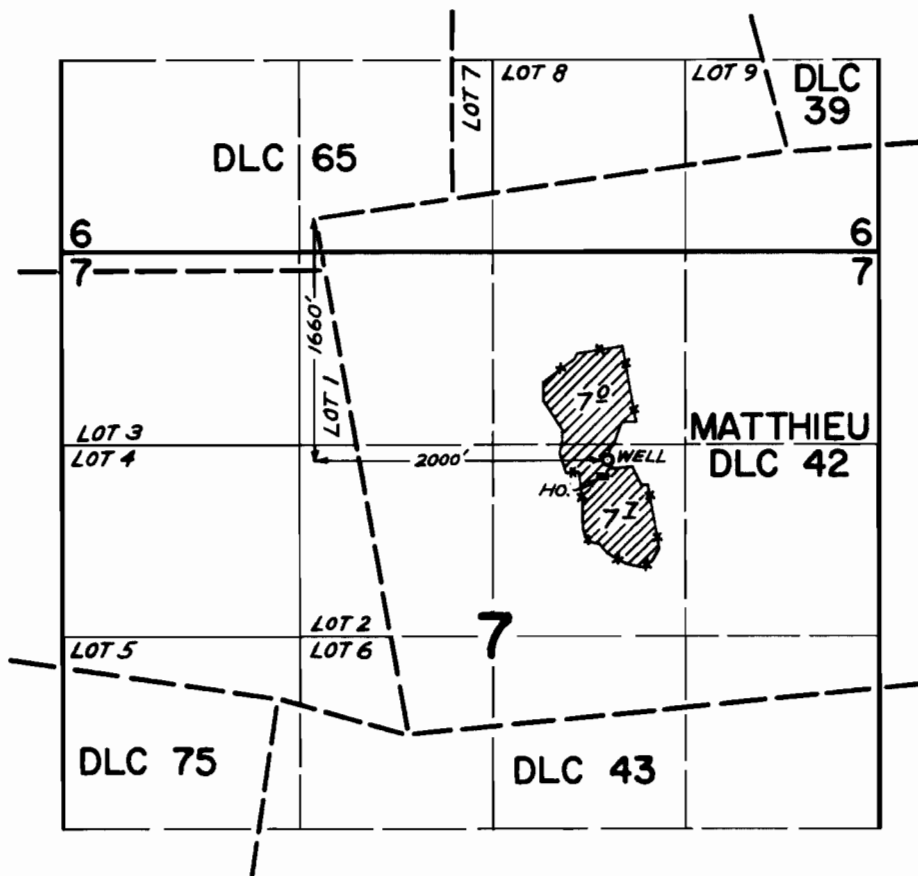


FINAL PROOF SURVEY
UNDER

Application No. G-3733 Permit No. G-3527
IN NAME OF

FRANCES M. CASHMAN

Surveyed JULY 14, 1971, by GREG BACA

T.4S. R.1W. Section 7, W.M.

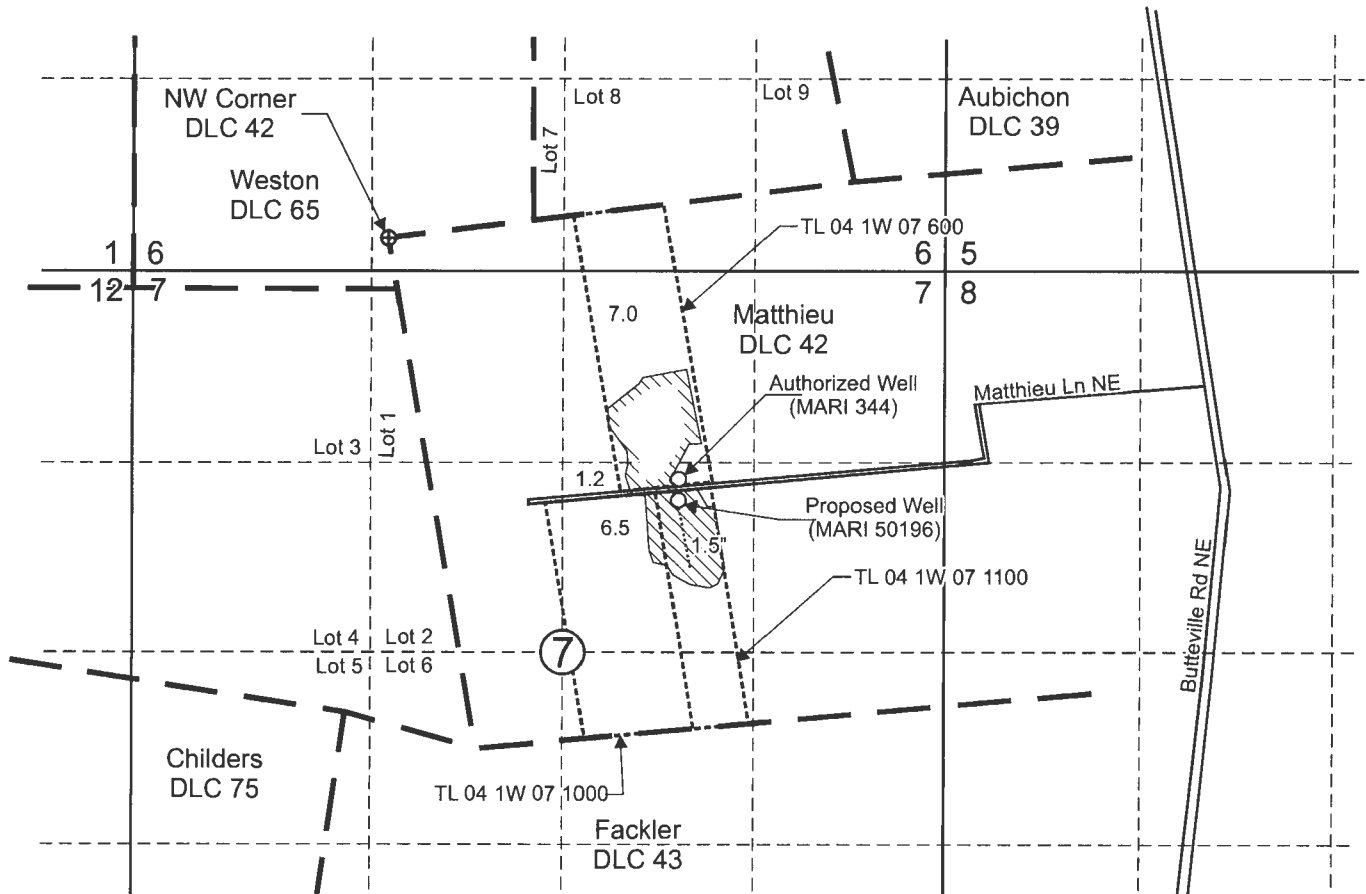

Authorized Well (MARI 344) is located 1,660 feet south and 2,000 feet east from the NW corner, DLC 42.

Proposed Well (MARI 50196) is located 1,045 feet north and 800 feet east from the center corner, Section 7.


 Area (8.2 Acres) irrigated under Certificate 38266, priority 11-28-1966, not affected by this transfer.

 Area (6.5 Acres) irrigated under Certificate 38266, priority 11-28-1966, affected by transfer.

----- Tax lot boundary

— • — Donation Land Claim boundary

..... Water main line

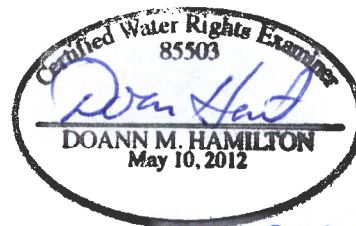

REVIEWS Jan 30 2017

Scale: 1" = 1,320'



This map was prepared for the purpose of identifying the location of a water right only and is not intended to provide legal dimensions or location of property ownership lines.

RECEIVED

DEC 20 2016

Water Right Transfer
Certificate 38266

Pacific Hydro-Geology Inc.

Keddie Farms c/o Reg Keddie
T.4S. R.1W. Section 7, W.M.

WATER RESOURCES DEPT
SALEM, OREGON

T 12539