


T. 32 S., R. 6 W., W.M.


SCALE: 1" = 400'

THE PURPOSE OF THIS MAP IS TO IDENTIFY THE LOCATION OF THE WATER RIGHT. IT IS NOT INTENDED TO PROVIDE INFORMATION RELATIVE TO THE LOCATION OF PROPERTY OWNERSHIP BOUNDARY LINES.

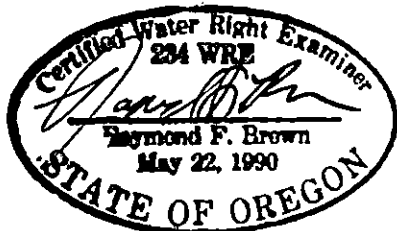

EXP. 12/31/2013

PART OF
TAX LOT 500,
SECTION 25,
T. 32 S., R. 6 W., W.M.

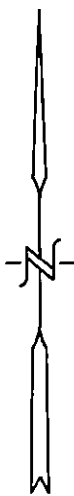

POINT OF
RE-DIVERSION
WITH FISH SCREEN,
BY-PASS DEVICE,
AND METER

CREEK

SENE
18.9 a.c.

EAST QUARTER CORNER
FOUND IRON PIPE

NWSE
9.9 a.c.

NESE
13.2 a.c.

POINT OF
RE-DIVERSION
IS 369 FEET NORTH AND
1968 FEET WEST OF THE
EAST QUARTER CORNER TO
SECTION 25, T. 32 S., R. 6 W., W.M.

U.S. INTERSTATE HWY. NO. 5

NOV 09 2017

SALEM, OR

S. 25, T. 32 S., R. 6 W., W.M.
S. 30, T. 32 S., R. 5 W., W.M.

FINAL PROOF SURVEY

UNDER

LEGEND:

Application No. S-86874, Permit No. S-54436



54436

IN NAME OF

ANDY L. OWENS

Surveyed SEPT. 05, 2013, by R.F. BROWN