

T25S R31E

FD. W.C.

4 3

4 3

9 10

POA IS 2770 FT. SOUTH AND 1280 FT. EAST FROM
THE TRUE NW COR. SEC. 3, T.25S., R.31E.

APOA IS 2490 FT. SOUTH AND 1530 FT. EAST
FROM THE TRUE NW COR. SEC. 3, T.25S., R.31E.

△ POA — WELL AND INLINE
FLOW METER

▲ APOA — WELL AND
INLINE FLOW METER

○ CENTER PIVOT

----- EXISTING MAINLINE

● FOUND RECORD SURVEY MONUMENT WHICH
IS 19.12 FT. EAST OF THE NW COR. SEC.
3, T.25S., R.31E.

▨ CURRENT PLACE OF USE

() TAX LOT

RECEIVED BY CWRD

JAN 23 2014

SALEM, OH



SCALE: 1" = 1320'


FINAL PROOF SURVEY
APPLICATION NO. G-15939
PERMIT NO. T-11267
SPECIAL ORDER VOL. 85, PG. 373

IN NAME OF
JAMES AND LONNY GREENE

BY

ROBERT D. BAGETT
217 N. CANYON BLVD.
JOHN DAY, OREGON
(541) 575-1251

DATE SURVEYED: SEPT. 25, 2013

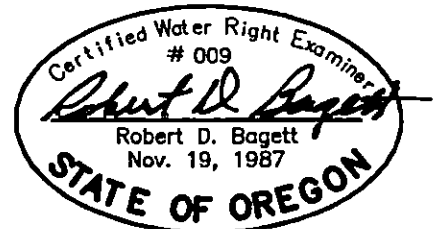

RENEWS 12-31-13

NOTE: THE PREPARATION OF THIS MAP WAS
FOR THE PURPOSE OF IDENTIFYING THE
LOCATION OF THE PROPOSED WATER RIGHT
AND HAS NO INTENT TO PROVIDE DIMENSIONS
OR LOCATION OF PROPERTY OWNERSHIP LINES.