CLAIM OF BENEFICIAL USE MAP

FOR: TOMMY & JANET PRESTIANNI


BY: NATHAN R. REED, CWRE T32S, R4W, W.M. SECTION 6 APPLICATION NO. S-87448 PERMIT NO. S-54600



SCALE: 1" = 400'

DATE SURVEYED: JULY 12, 2013

POD IS LOCATED 1443 FEET NORTH AND 1121 FEET WEST FROM THE SE CORNER OF SECTION 6.

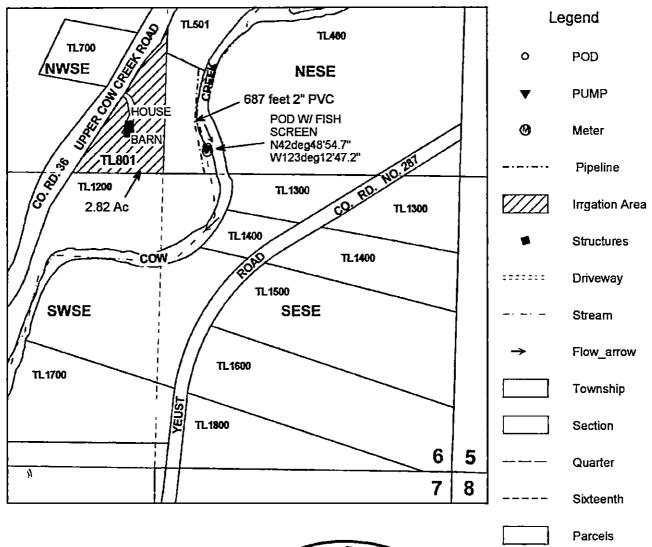

NAT YAN R. MEED

MAY 3. 2011

ETAKES DON 31 2014

MAP PREPARED FOR: TOMMY & JANET PRESTIANNI 2741 UPPER COW CREEK ROAD AZALEA, OR 97410

RECEIVED BY OWRD

JUL 2 2 2013

THE PURPOSE OF THIS MAP IS TO IDENTIFY THE LOCATION OF THE WATER RIGHT. IT IS NOT INTENDED TO PROVIDE INFORMATION RELATIVE TO THE LOCATION OF PROPERTY OWNERSHIP BOUNDARY LINES.

SALEM, OR MAP PREPARED BY: NATHAN R. REED, P.E., CWRE 1113 SE CASS AV ROSEBURG, OR 97470