


CLAIM OF BENEFICIAL USE MAP UNDER PERMIT S-52622


T 40 S, R 8 W, WM, JOSEPHINE COUNTY

Section 25 - E1/2 SW1/4

July 8, 2011

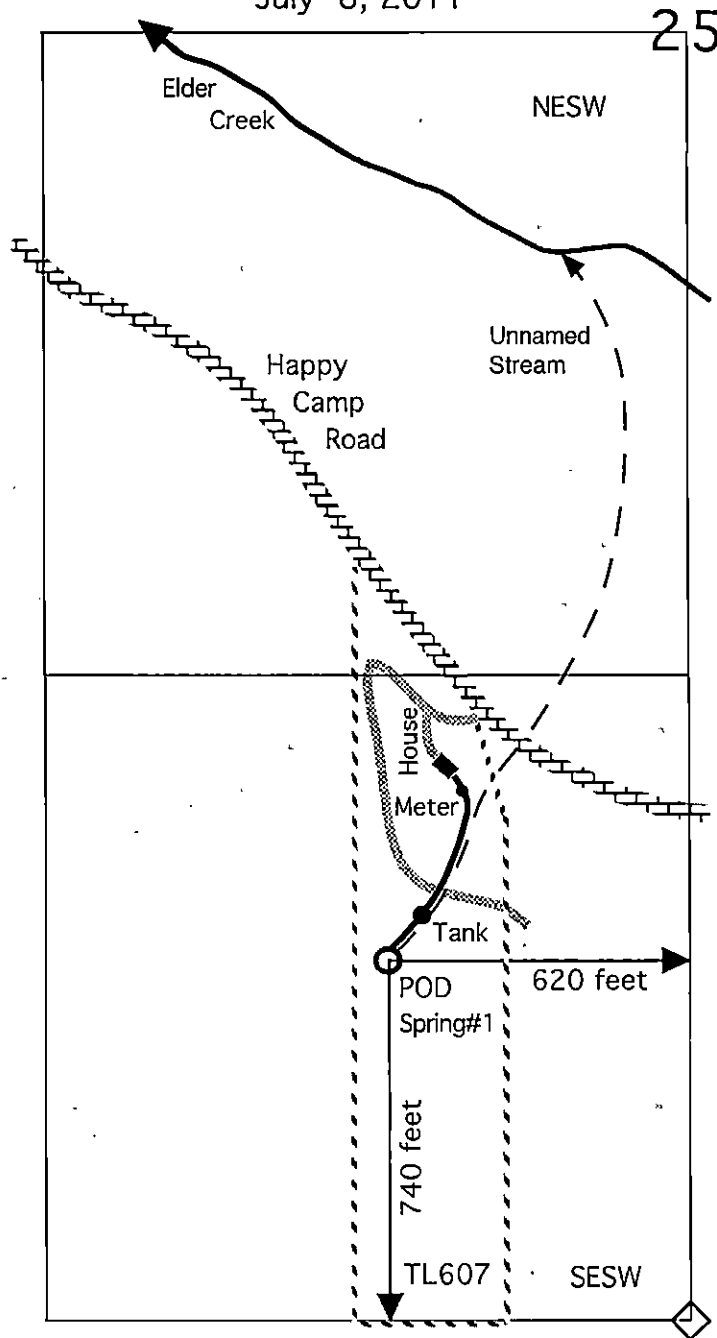

N
1"=400'

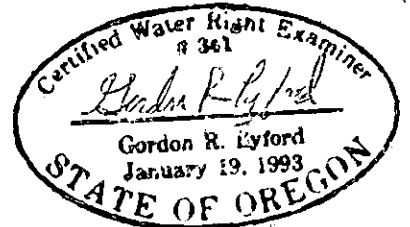

7-8-2011
exp 12-31-2012

Application S-80672 and Permit S-52622 with a priority of November 29, 1995

- Above ground 325 gallon tank
- Above ground 3/4 inch diameter poly pipe and hose from spring #1 to the house
- ◆ Household and place of use
- Driveway

RECEIVED
WATER DIVISION
SALEM, OR

This map was drawn by Gordon R. Lyford for Contessa Garnier to support her claim of beneficial use of water for domestic use and human consumption from a spring. Contessa Garnier owns tax lot 607.

This map was prepared for the purpose of identifying the location of water rights only and is not intended to provide legal dimensions or the location of property ownership lines.