


# CLAIM OF BENEFICIAL USE MAP



SECTION 24, T3S, R4W, WM  
 LOT 100 OF TAX MAP 3S 4W SEC. 24  
 YAMHILL COUNTY, OREGON

PREPARED FOR:  
 MARSH FAMILY INVESTMENTS, LLC  
 APPLICATION G-16785  
 PERMIT G-16328

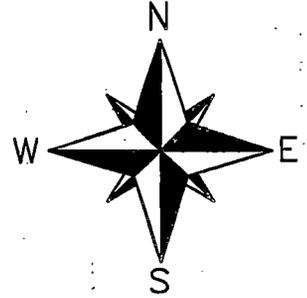

## LEGEND

- POINT OF APPROPRIATION
- ◆ SECTION CORNER
- PROPERTY LINE
- SECTION LINE
- - - 16TH LINE
- · - · - PIPELINE
- ▨ PLACE OF USE

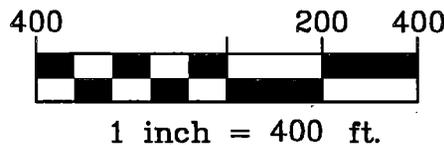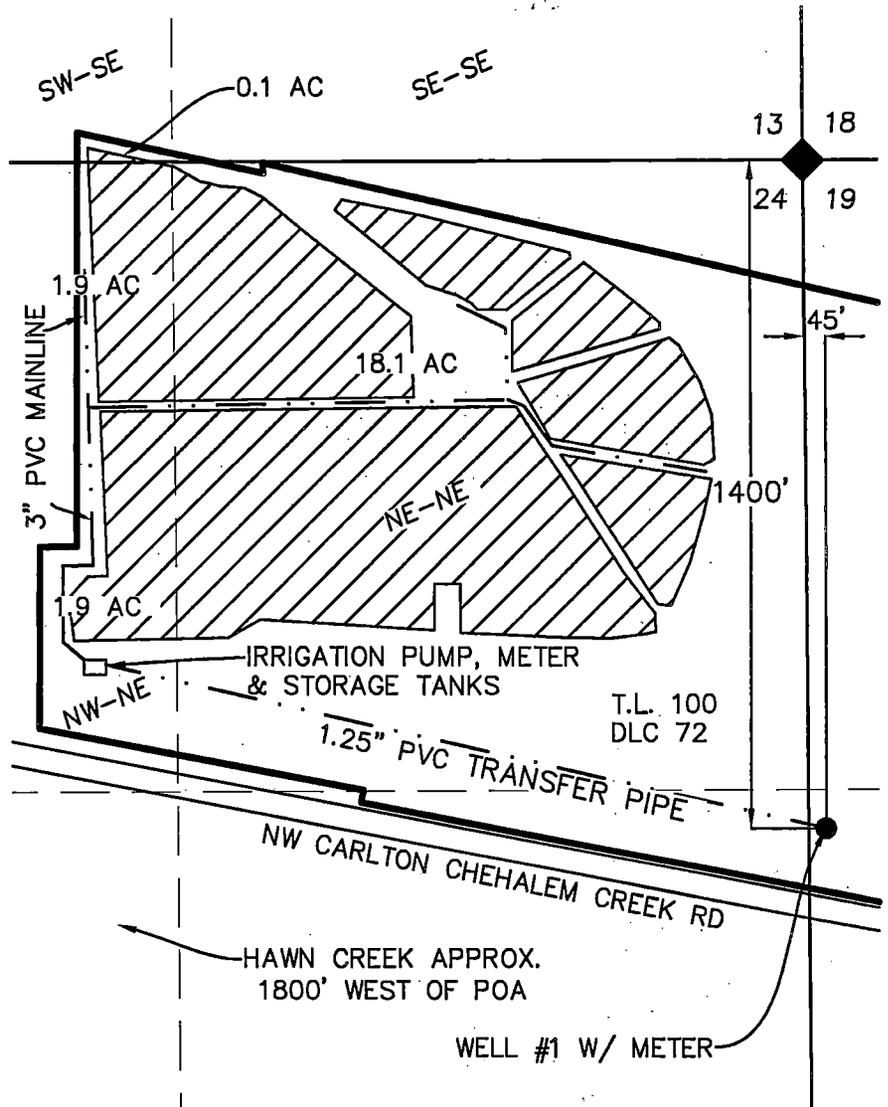

MAP BASES: YAMHILL COUNTY TAX MAP T3S R4W SEC. 24  
 2012 AERIAL PHOTO FROM GOOGLE EARTH®  
 BLM T3S R4W MASTER TITLE PLAT

THIS MAP WAS PREPARED FOR THE PURPOSE OF IDENTIFYING THE LOCATION OF A WATER RIGHT ONLY AND IS NOT INTENDED TO PROVIDE LEGAL DIMENSIONS OR LOCATION OF PROPERTY OWNERSHIP LINES.



Project: 313-007  
 By: Dylan Hitner  
 Checked by: Eric Urstadt  
 Date: May 13, 2013