


CLAIM OF BENEFICIAL USE FOR
RON & ANNA POWERS
SE1/4, NE1/4, SEC. 36
T.33, R. 15 W., W. M.
CURRY COUNTY, OREGON



1" = 200'
JAN. 2013

RON & ANNA POWERS
39273 HWY 101
PORT ORFORD, OR 97465

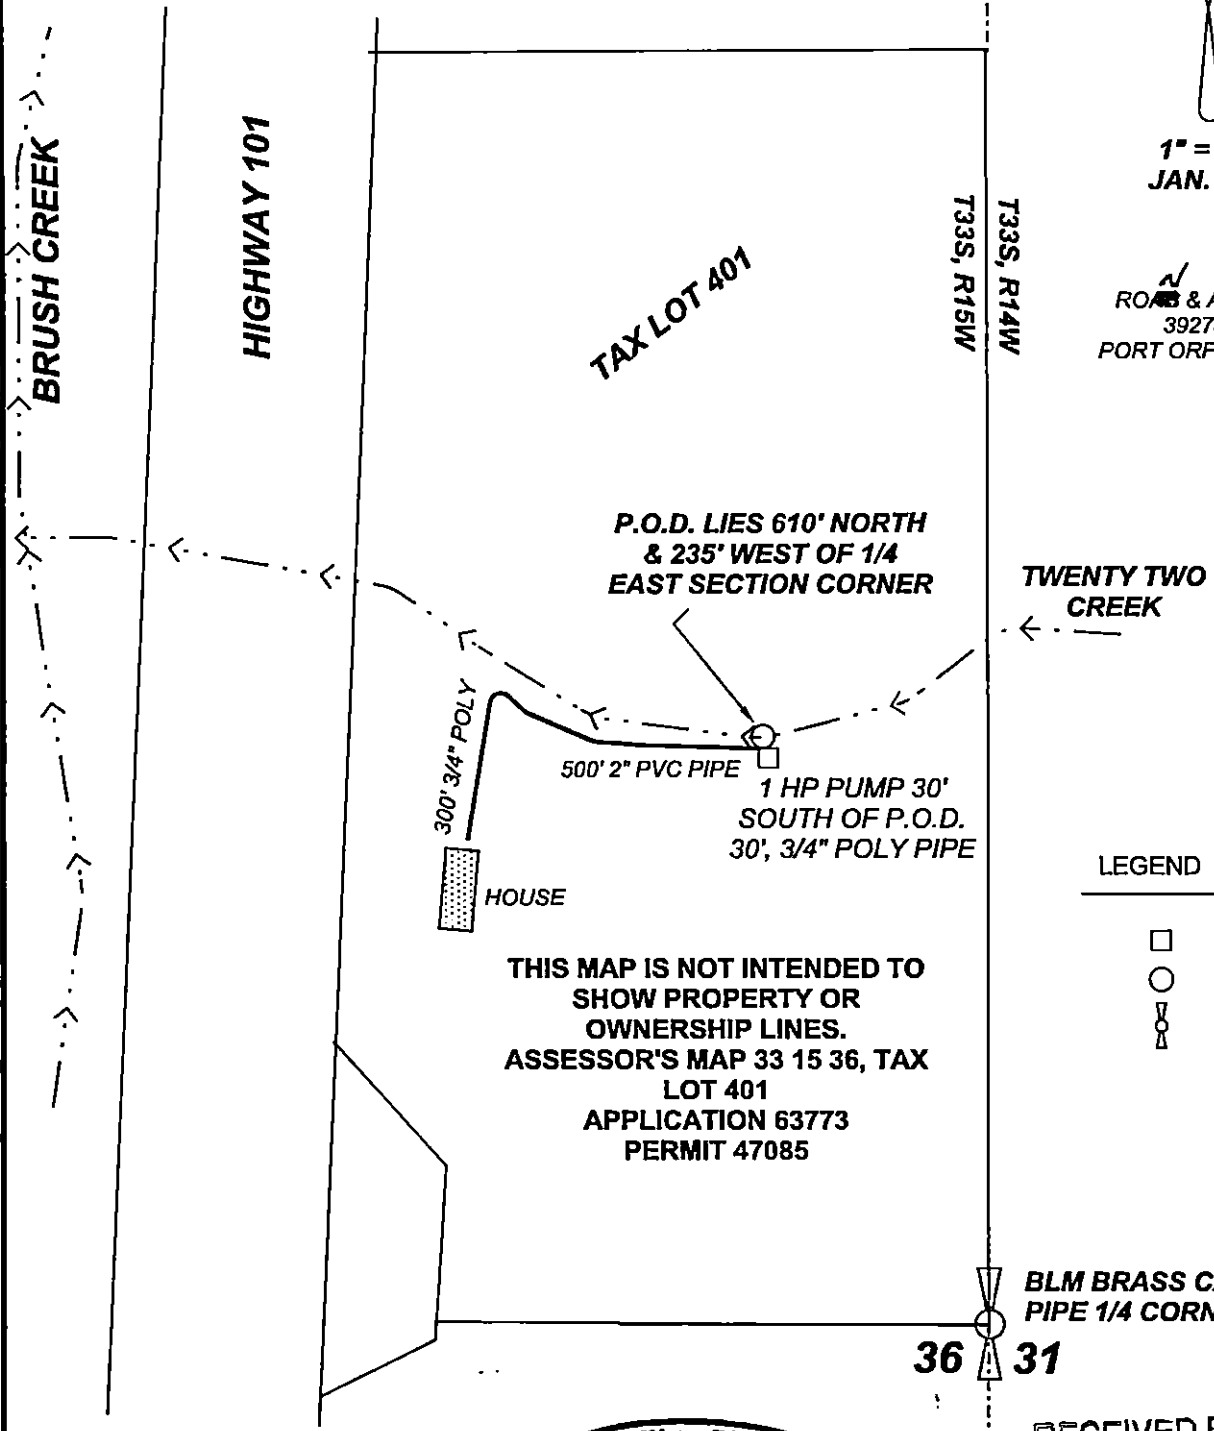

THIS MAP IS NOT INTENDED TO
SHOW PROPERTY OR
OWNERSHIP LINES.
ASSESSOR'S MAP 33 15 36, TAX
LOT 401
APPLICATION 63773
PERMIT 47085

- LEGEND
- PUMP
 - P.O.D.
 - ⊗ BRASS CAP


BLM BRASS CAPPED
PIPE 1/4 CORNER
36 31

RECEIVED BY OWRD

JUL 19 2013

SALEM, OR

FLAVIN LAND SURVEYING
BRYAN M. FLAVIN PLS - CWRE
32053 CEDAR VALLEY ROAD
GOLD BEACH, OREGON 97444
541-247-6485

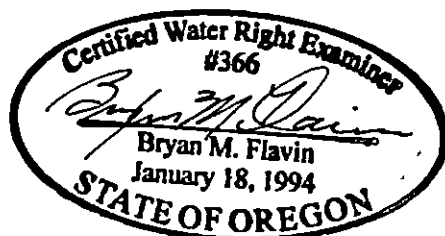

12-31-13