


T.5S. R.1E. Section 6, W.M.

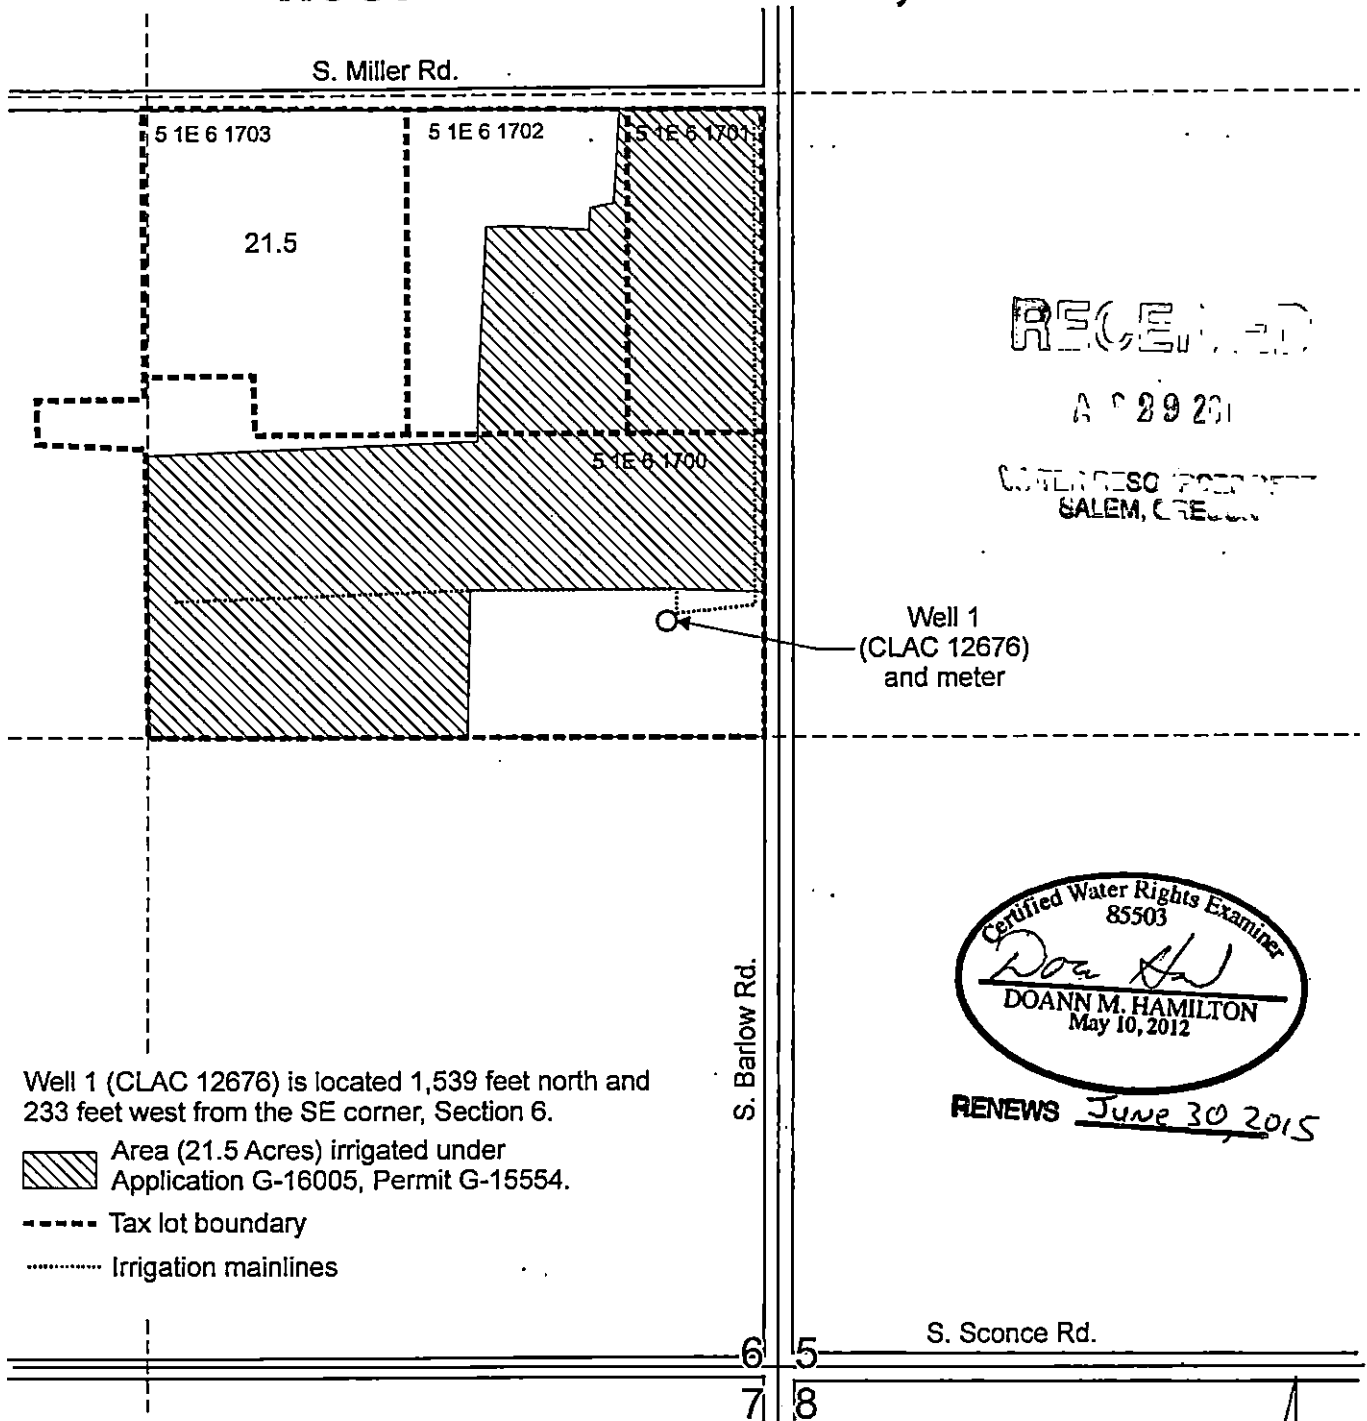

RECEIVED

AUG 29 2011

SALEM, OREGON


Well 1
(CLAC 12676)
and meter

Well 1 (CLAC 12676) is located 1,539 feet north and 233 feet west from the SE corner, Section 6.

 Area (21.5 Acres) irrigated under Application G-16005, Permit G-15554.


 Tax lot boundary

 Irrigation mainlines

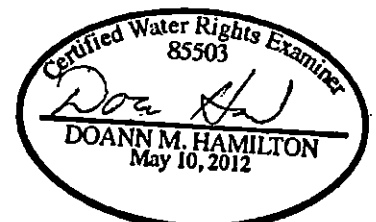

RENEWS June 30, 2015

Scale: 1" = 400'

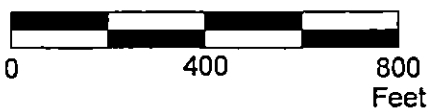

This map was prepared for the purpose of identifying the location of a water right only and is not intended to provide legal dimensions or location of property ownership lines.

Claim of Beneficial Use Map
Application G-16005, Permit G-15554

Steve Millar
T.5S. R.1E. Section 6, W.M.

Pacific Hydro-Geology Inc.

08/2013