


WATER RIGHTS MAP

LOCATED IN THE NW $\frac{1}{4}$ OF SE $\frac{1}{4}$ OF SEC. 7, T35S, R11W, TL 1000/PORION OF GOV'T LOT 3
APPLICATION #S60918 PERMIT #S45388


LEGEND

- | | |
|---|---|
| <ul style="list-style-type: none"> P.O.D. CENTER $\frac{1}{4}$ CORNER OF DESCRIBED SECTION TAX LOT BOUNDARY SNOUT CREEK NEW WATERLINE EXISTING WATERLINE | <ul style="list-style-type: none"> 1" PVC PUMPHOUSE SUPPLY LINE PUMPHOUSE (NTS) ESTIMATED IRRIGATION AREA (1.00 AC EXCLUDING EXISTING STRUCTURES) TWO 1500 GAL PLASTIC STORAGE TANKS (NTS)
ONE 1000 GAL CONCRETE STORAGE TANK (NTS) |
|---|---|

DISCLAIMER: THIS MAP WAS PREPARED FOR THE PURPOSE OF IDENTIFYING THE LOCATION OF A WATER RIGHT ONLY AND IS NOT INTENDED TO PROVIDE LEGAL DIMENSIONS OF LOCATION OF PROPERTY LINES.

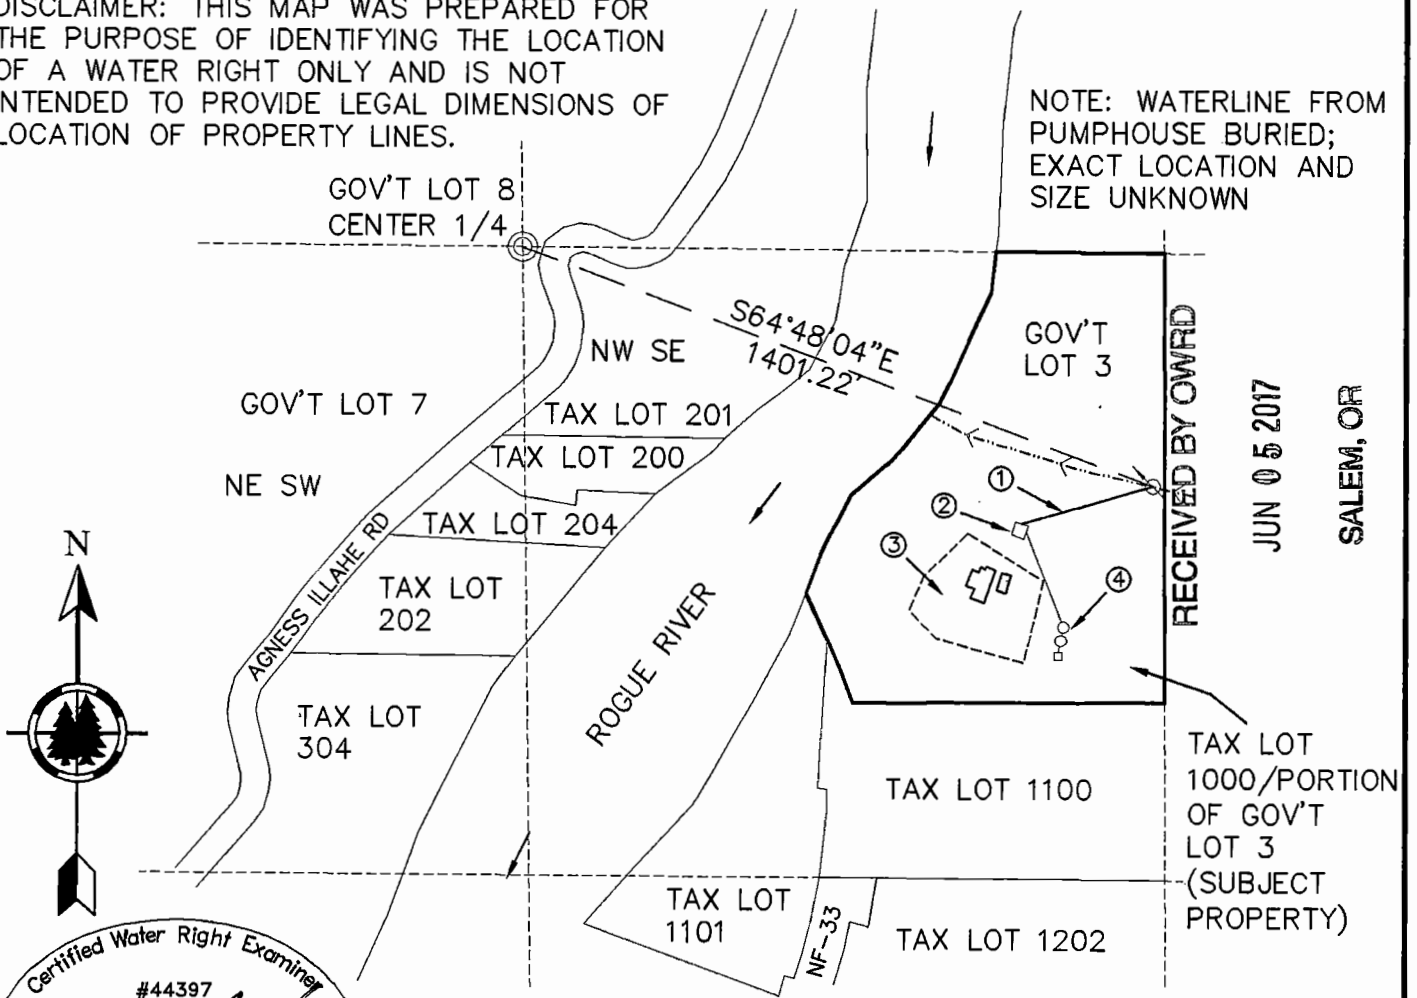

Certified Water Right Examiner
#44397
Ralph E. Dunham
Ralph E. Dunham
June 3, 2016
STATE OF OREGON
EXPIRES 12/31/17

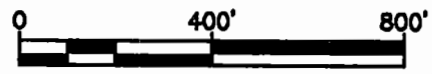

Stuntzner <i>Engineering & Forestry, LLC</i>		705 S. 4TH ST. P.O. BOX 118 COOS BAY, OREGON 97420 Engineering - Land Surveying - Forestry - Land Planning - Water Rights	PHONE: (541) 267-2872 FAX: (541) 267-0588 www.stuntzner.com
JOB #: 000-0-000	PREPARED FOR:	Jeffery and Catherine McKeown	
DATE: FEB 2017	FOR:	890 Telegraph Hill	
DRAWN BY: AER		Coos Bay, OR 97420	
CHECKED BY: CDH	FILE NAME: Agness Water Map.dwg	SHEET 1 OF 1	