

T4SR3W

FIGURE 1

Proposed Change to Water Right Certificate #35696 (Transfer T-10926, Permit #G 1664) City of Dayton, Oregon

LEGEND

- ⊙ Existing POA
- ▲ Proposed Additional POA
- Existing Place of Use (POU)
- ▭ Urban Growth Boundary
- ⊕ City Taxlots
- ≡ Major Roads
- ~ Watercourses
- ☑ Waterbodies

POA Location Description


New POA (YAMH 125)
 Located 540 feet South and 260 feet East from the NW corner of Section 20, Township 4 South, Range 3 East (W.M.)

Existing POA (YAMH 5338)
 Located 1200 feet North and 1520 feet West from the SE corner of Section 17, Township 4 South, Range 3 East (W.M.)

NOTE
This map is not intended to provide legal dimensions or locations of property ownership lines.




EXPIRATION DATE: 12/11

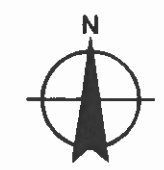

Scale

1 inch equals 1,320 feet

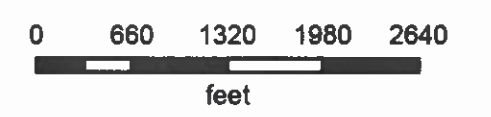

MAP NOTES:

Projection: Oregon State Plane North Zone
 Datum: North American Datum of 1983
 Date: February 14, 2011
 Data Sources: Yamhill County GIS



RECEIVED

FEB 25 2011

WATER RESOURCES DEPT
SALEM, OREGON

DAYTON

Water Meter Located Inside of Pump House

New POA Flower Lane Well (YAMH 125)

Existing POA Post Office Well (YAMH 5338)

