


EXHIBIT B

T28S, R33E, W.M.
Harney County, Oregon

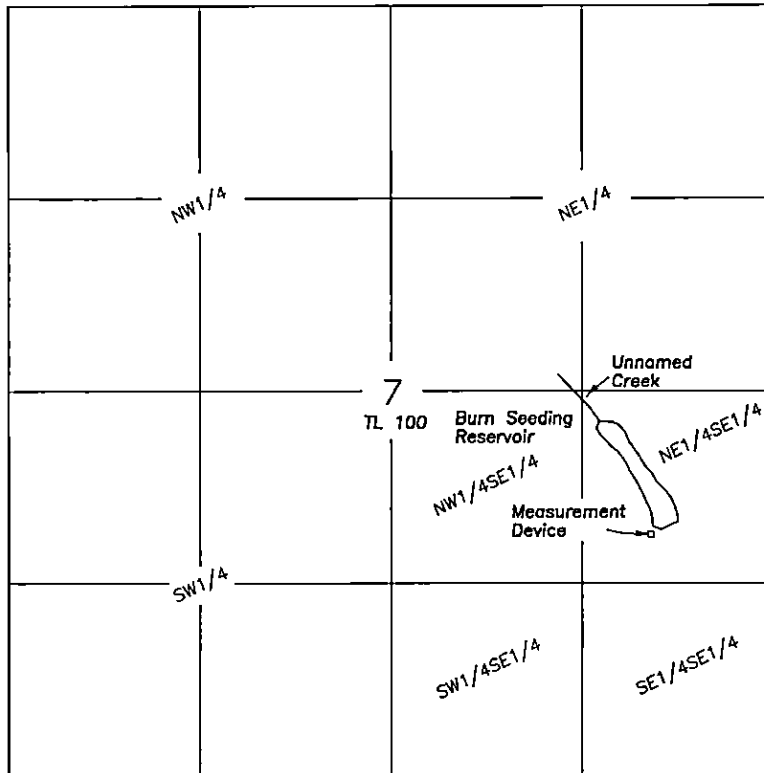

SCALE 1"=1320'

Outlet is located 1870' North & 830' West of the
SE corner of Section 7.

Measuring device is located 6' South of the outlet

FINAL PROOF SURVEY
CLAIM OF BENEFICIAL USE
BURN SEEDING RESERVOIR

For

Bureau of Land Management

September 15, 2017

LEGEND

Application No. R-66484

Permit No. R-11096

Priority 1/16/1985

A portion of Tax Lot
28-33 TL100

NOTE: Tax Lot 100 is owned by the BLM
and is more that 10,000 acres.
Therefore only a portion of the tax
lot boundary can be shown.

Prepared by

Cornerstone Surveying, Inc

P.O. BOX 33

JOHN DAY, OR. 97845

(541)575-1813

cornerstonesurvey@centurytel.net

NOTE: The preparation of this map
was for the purpose of identifying
the location of the proposed water
right and has no intent to provide
dimensions or location of property
ownership lines.

RECEIVED BY OWRD

NOV 03 2017

SALEM, OR

