


# CLAIM OF BENEFICIAL USE MAP

T. 13 S R. 2 W WM. SEC. 31

T. 13 S R. 3 W WM. SEC. 36

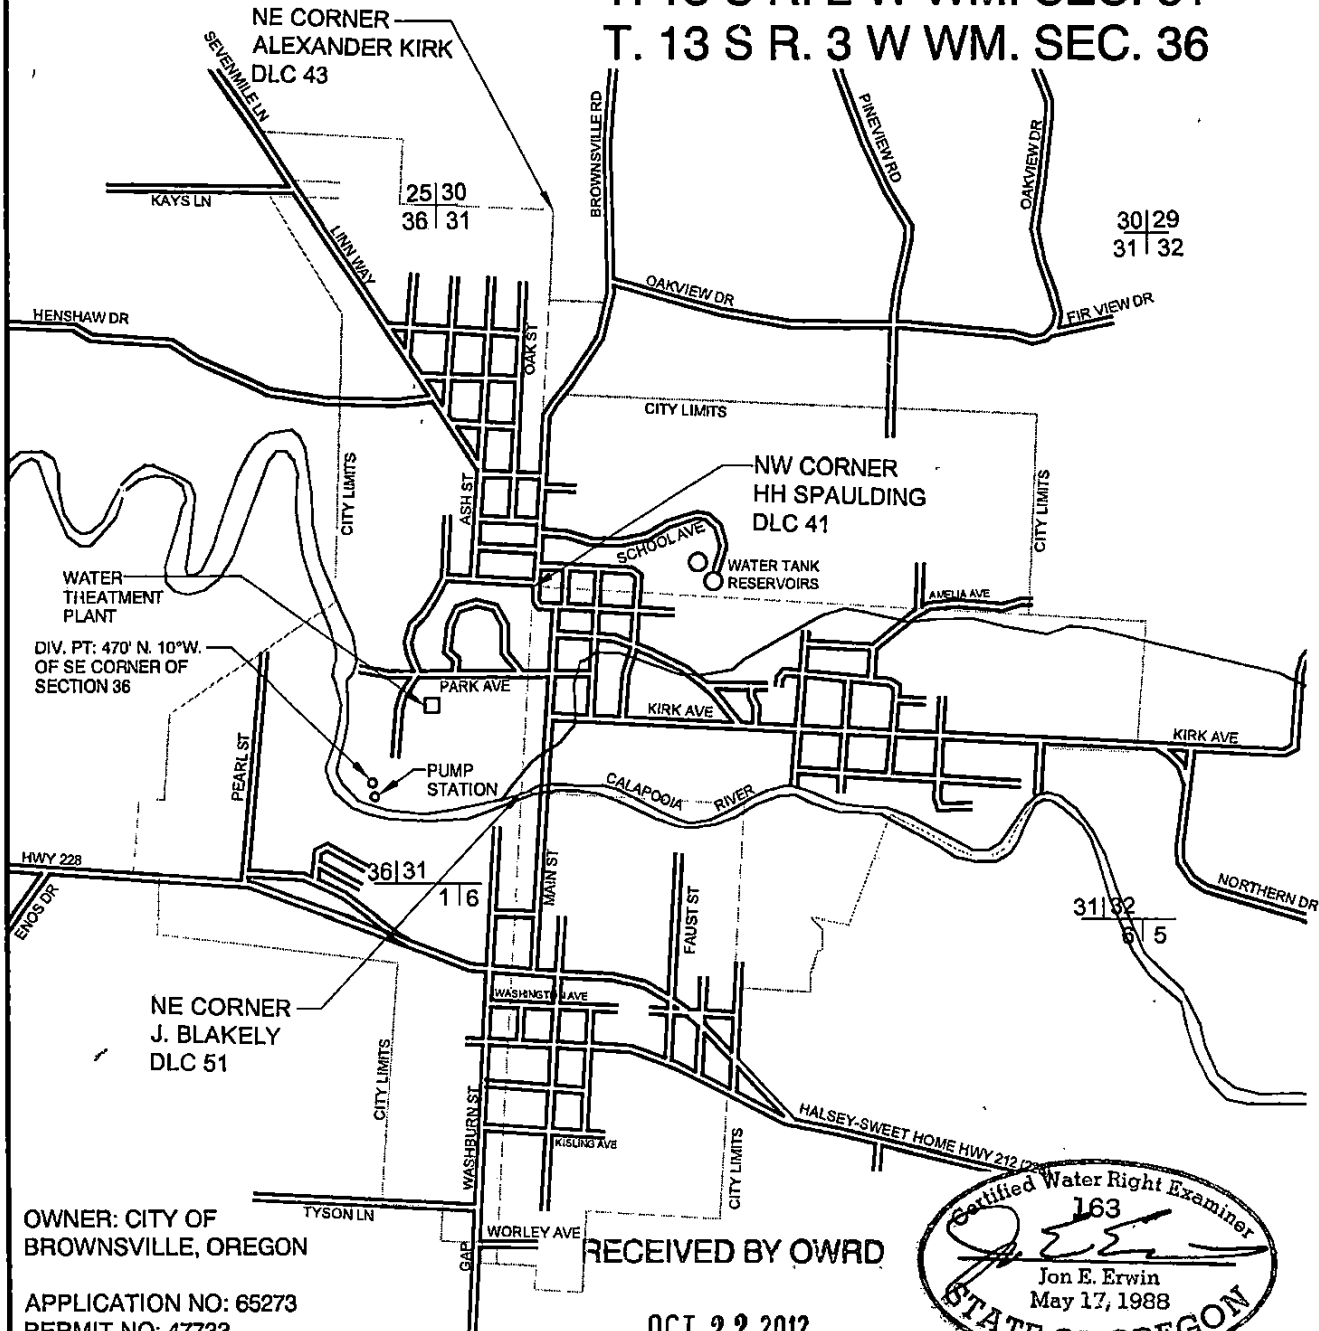


OWNER: CITY OF  
BROWNSVILLE, OREGON

APPLICATION NO: 65273  
PERMIT NO: 47733

RECEIVED BY OWRD

OCT 22 2012

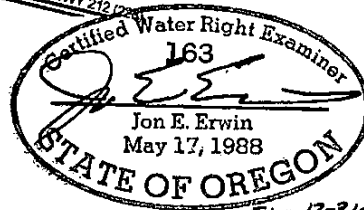

**NOTE:**

THIS MAP IS FOR THE PURPOSE OF IDENTIFYING THE LOCATION OF WATER RIGHTS AND HAS NO INTENT TO DIMENSION OR LOCATE PROPERTY OWNERSHIP LINES

SALEM, OR



0 1320 2640



SCALE: 1" = 1320'

**ERWIN CONSULTING  
ENGINEERING**

Date: 9/9/12  
Dwn By: MLM  
Scale: 1"=1320'

**BROWNSVILLE, OREGON**  
T13-14S, R2-3W, Sections 1,6,31 + 36.  
W.M. LINN COUNTY