



**Proof Survey Map  
Transfer T-6404  
T 35 S & T 36 S, R 2 W, W.M.**

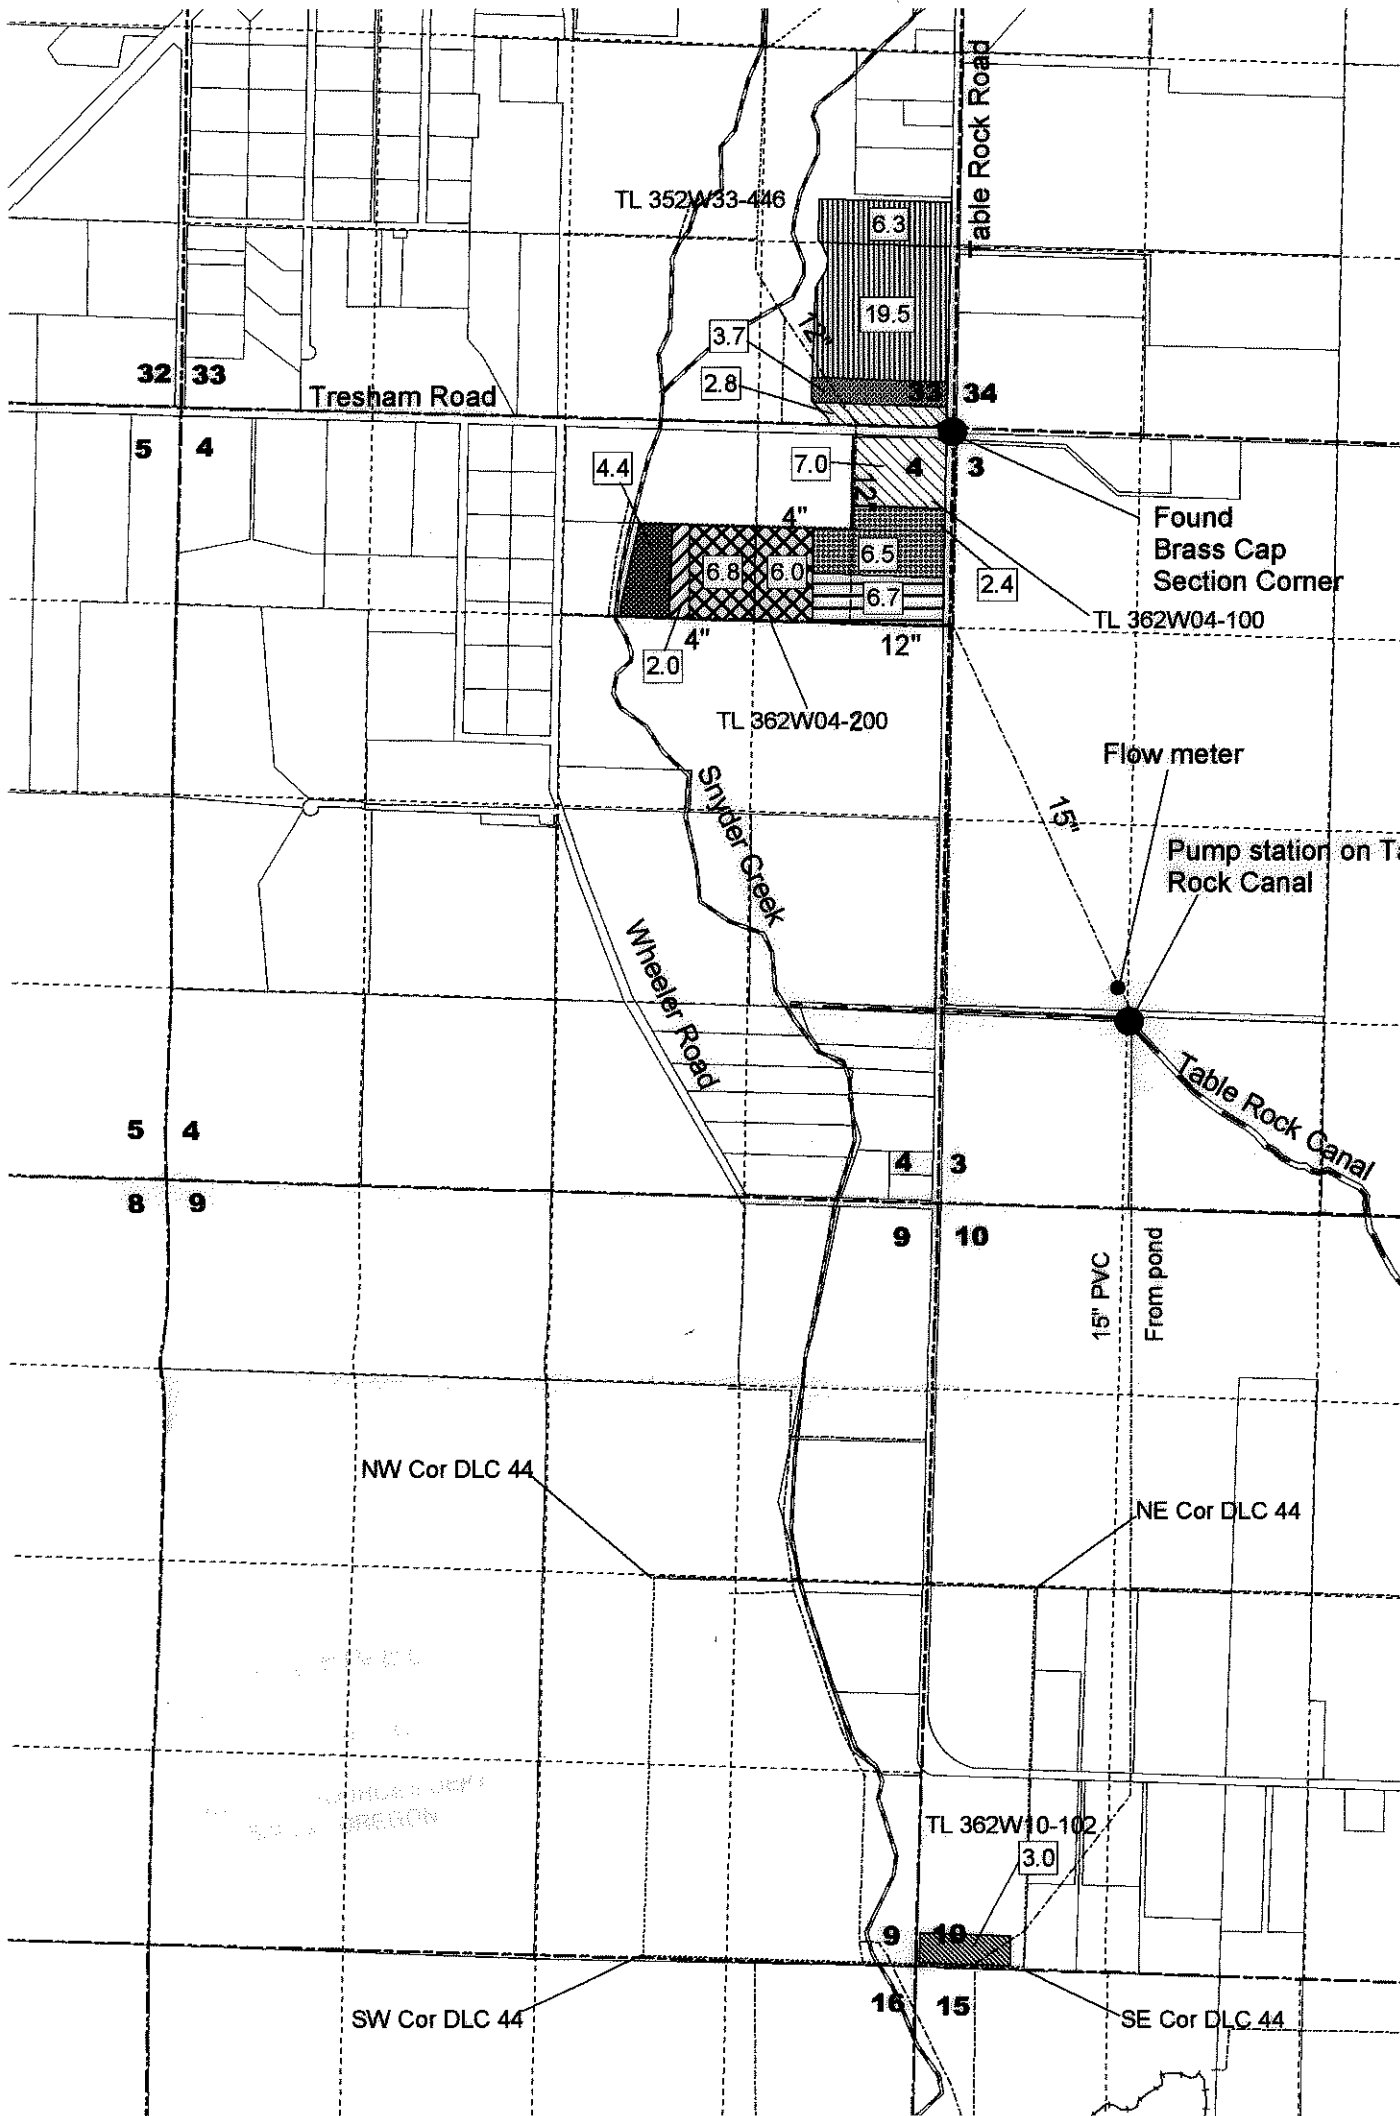


**Legend**

- "TO" Cert 36767
- "TO" Cert 32751
- "TO" Cert 32750
- "TO" Cert 32745
- "TO" Cert 32736
- "TO" Cert 32733
- "TO" Cert 32730
- "TO" Cert 32729
- "TO" Cert 32726
- PVC pipe line
- Alum Main line
- Section line
- Quarter-quarter line
- Creek
- Table Rock Canal

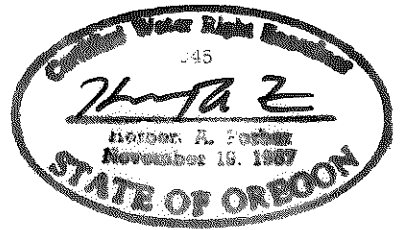

RENEWAL DATE 12-31-07

**Note: This map for water right purposes and not to be used for property line location**

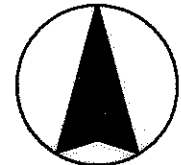

**All maps  
Scale 1" = 1320'**

**FARBER SURVEYING**  
 PO Box 5286  
 Central Point, Oregon 97502  
 Phone 541-664-5399  
 Fax 541-664-5605  
 Email [farber@farbersurveying.com](mailto:farber@farbersurveying.com)


