



Proof Survey Map
Transfer T-6404
T 35 S & T 36 S, R 2 W, W.M.

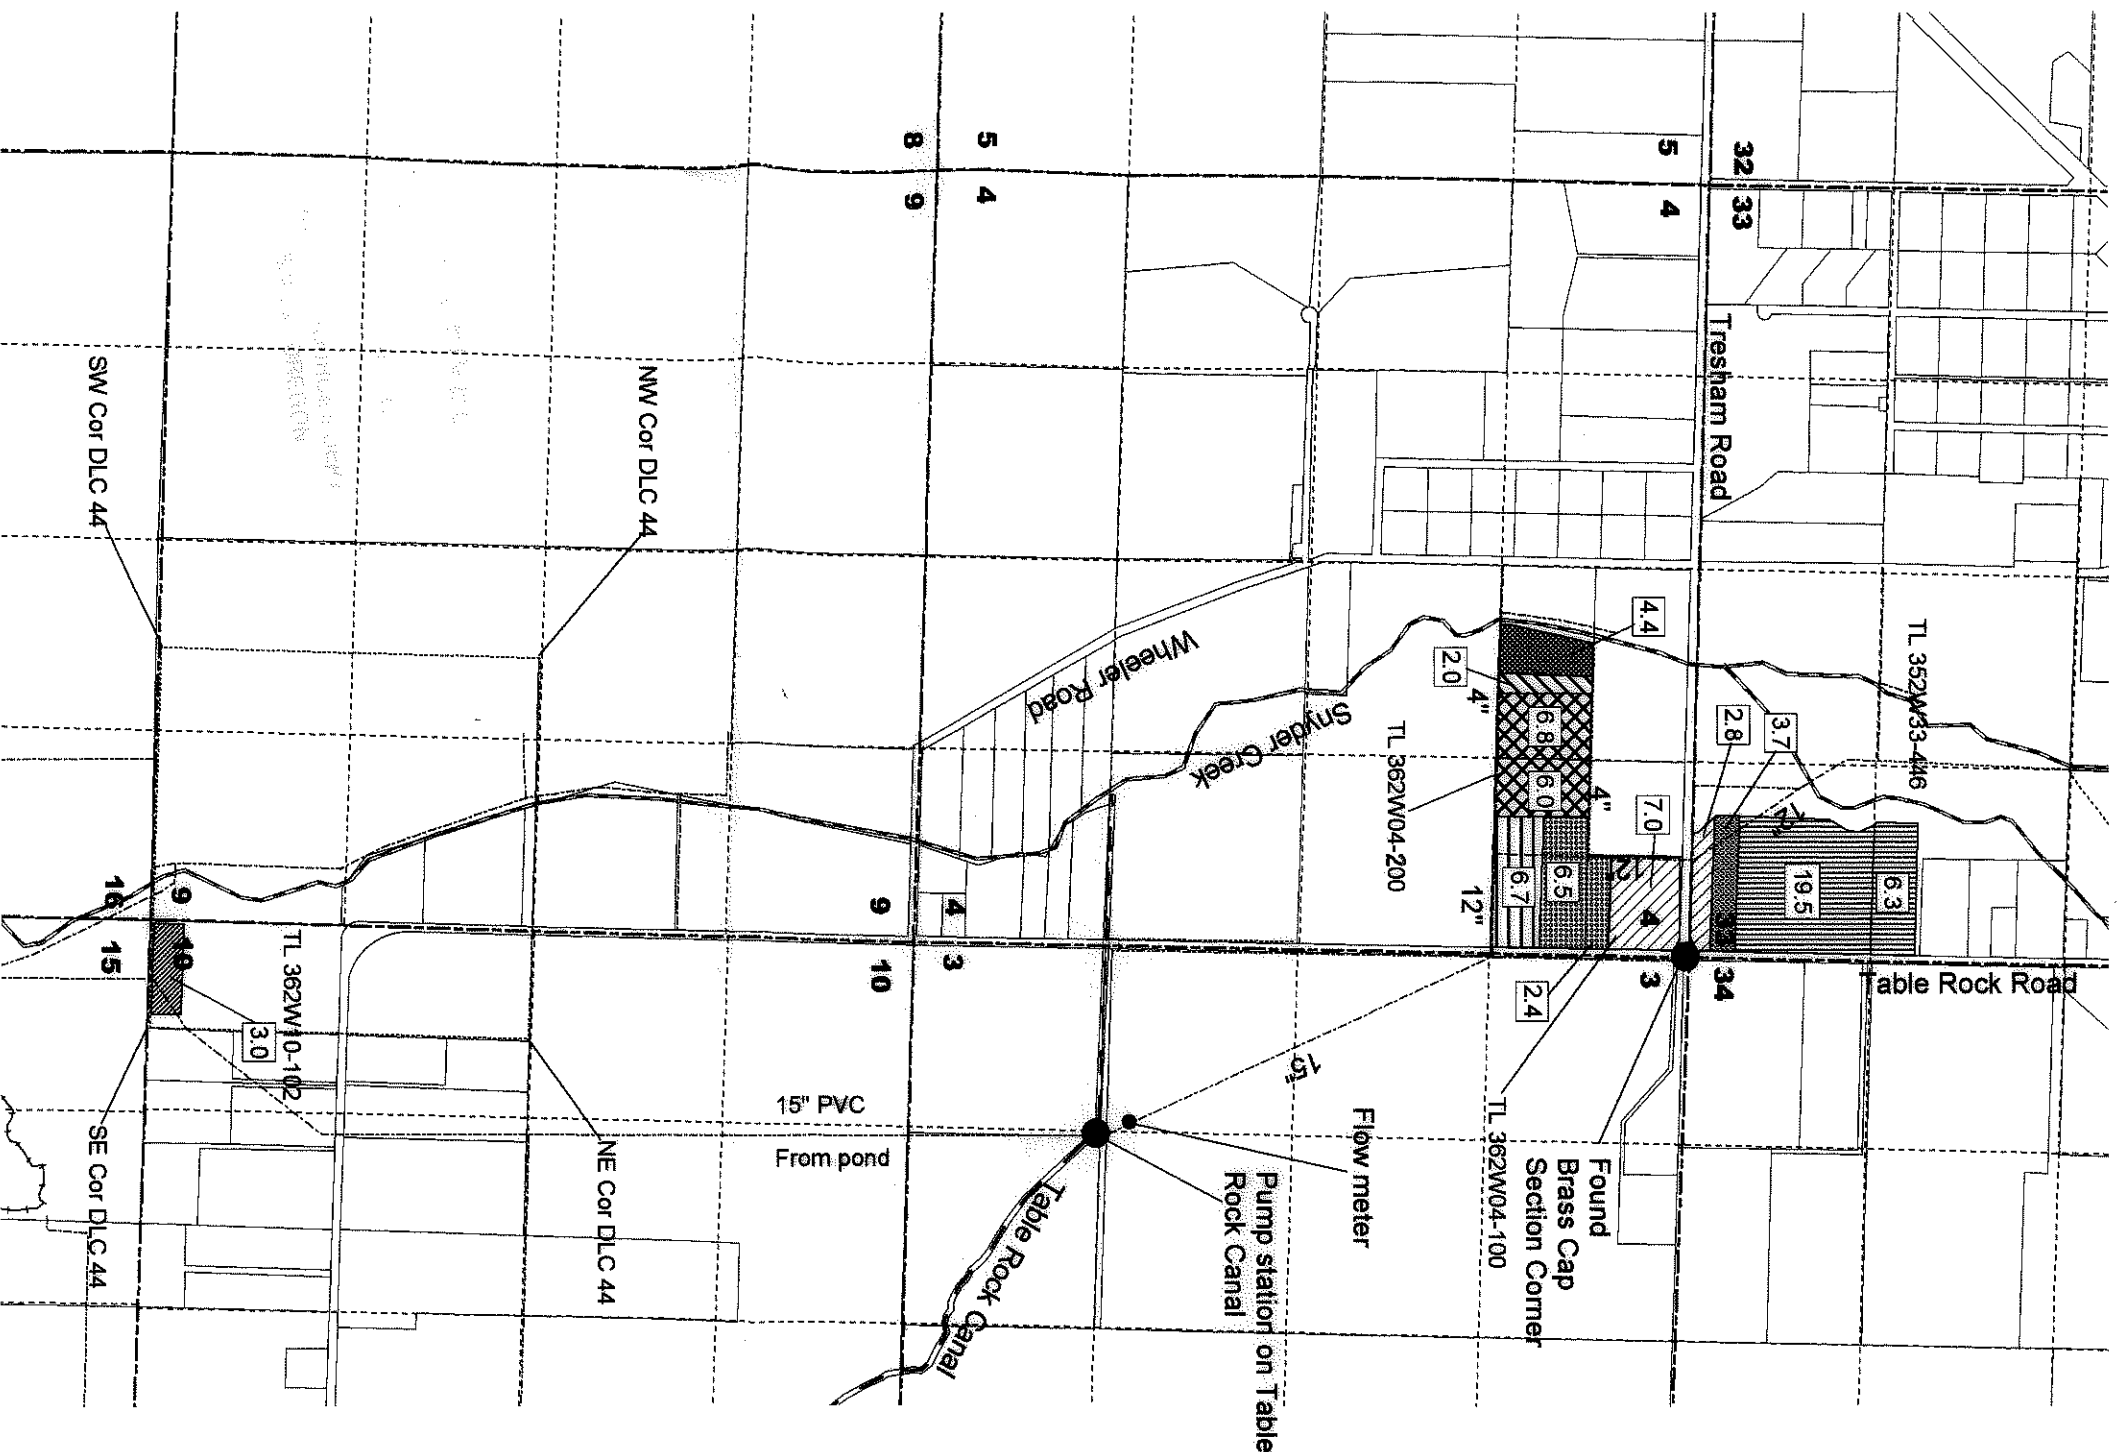


Legend

| | |
|--|----------------------|
| | "TO" Cert 36767 |
| | "TO" Cert 32751 |
| | "TO" Cert 32750 |
| | "TO" Cert 32745 |
| | "TO" Cert 32736 |
| | "TO" Cert 32733 |
| | "TO" Cert 32730 |
| | "TO" Cert 32729 |
| | "TO" Cert 32726 |
| | PVC pipe line |
| | Alum Main line |
| | Section line |
| | Quarter-quarter line |
| | Creek |
| | Table Rock Canal |

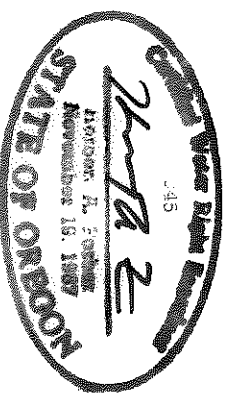

RENEWAL DATE 12-31-07

Note: This map for water right purposes and not to be used for property line location

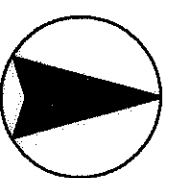

All maps
 Scale 1" = 1320'

FARBER SURVEYING
 PO Box 5286
 Central Point, Oregon 97502
 Phone 541-664-5590
 Fax 541-664-5085
 Email: info@farbersurveying.com

Fisher & Sons, Inc.
 431 Oak Street
 Central Point, Oregon

