


T23S R32E

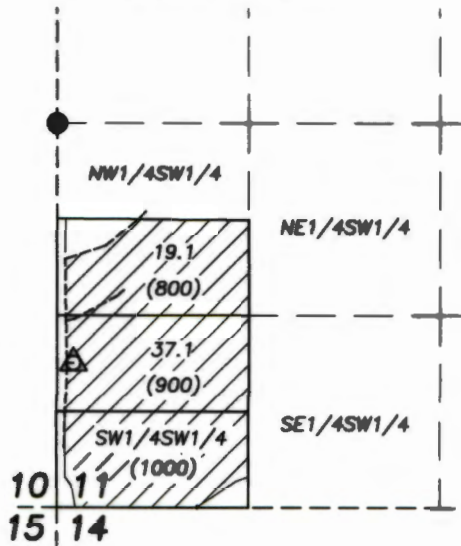

POA IS 1650 FT. SOUTH AND 110 FT. EAST OF THE W1/4 COR. SEC. 11, T.23S., R.32E.



SCALE: 1" = 1320'

FINAL PROOF SURVEY
APPLICATION NO. G-16133
PERMIT NO. G-15960

IN NAME OF
S. LARRY JOHNSON

BY

ROBERT D. BAGETT
217 N. CANYON BLVD.
JOHN DAY, OREGON
(541) 575-1251

DATE SURVEYED: SEPT. 25, 2013

△ POA - WELL AND INLINE
FLOW METER

----- EXISTING MAINLINE - OPEN DISCHARGE

● FOUND RECORD SURVEY MONUMENT AT
THE W1/4 CORNER SECTION 11


▨ CURRENT PLACE OF USE

() TAX LOT

RECEIVED BY OWRD

DEC 18 2013

SALEM, OR

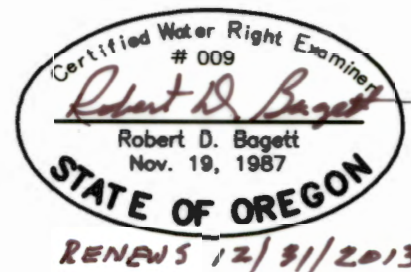

NOTE: THE PREPARATION OF THIS MAP WAS FOR THE PURPOSE OF IDENTIFYING THE LOCATION OF THE PROPOSED WATER RIGHT AND HAS NO INTENT TO PROVIDE DIMENSIONS OR LOCATION OF PROPERTY OWNERSHIP LINES.