

RECEIVED



FEB 14 2013

Claim of Beneficial Use Map Permit S-54424 (Application S-86689)

Water Right in the Name of RSG Forest Products, Inc.

WATER RESOURCES DEPT Township 6 North, Range 5 West, Sections 15 & 16 (W.M.)

Certified Water Rights Examiner Stamp

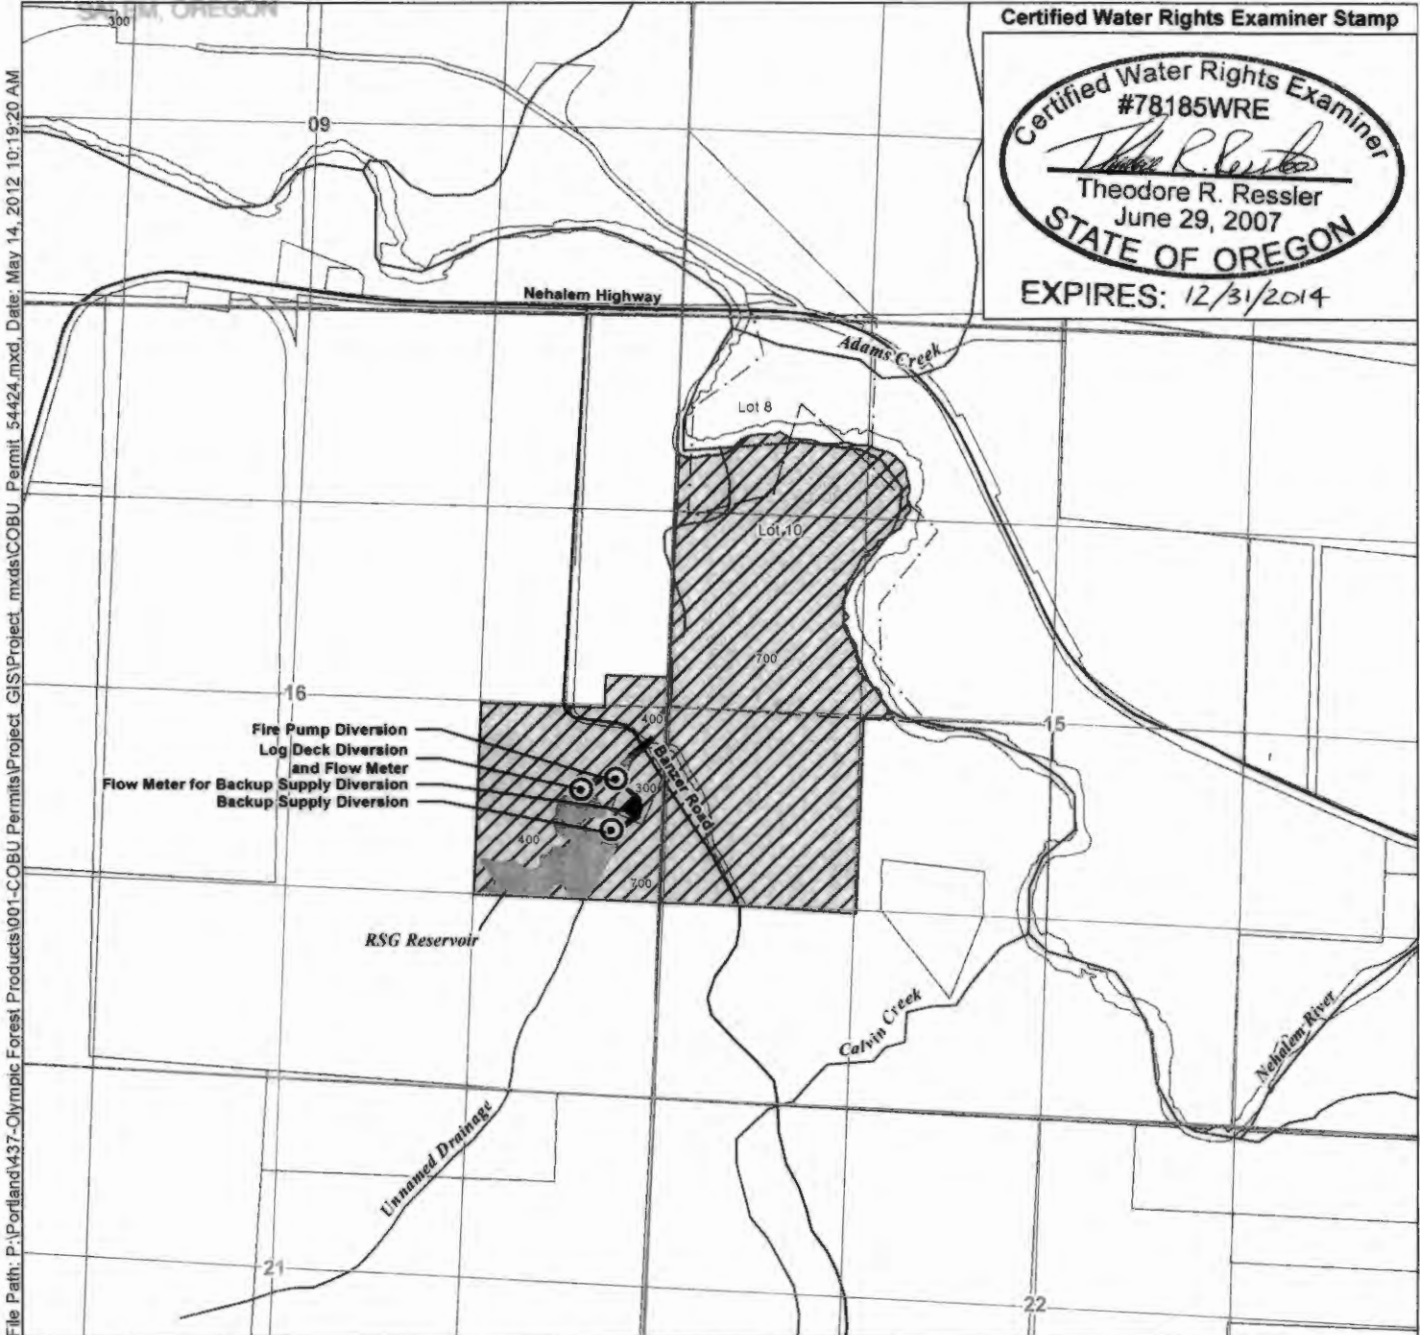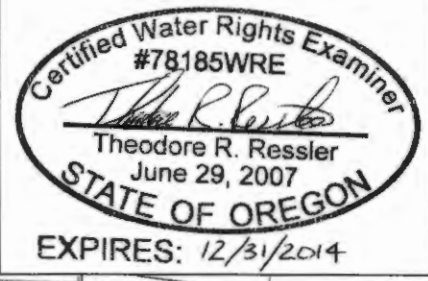

File Path: P:\Portland\437-Olympic Forest Products\001-COBU Permits\Project_GIS\Project_mxd\COBU_Permit_54424.mxd, Date: May 14, 2012 10:19:20 AM

LEGEND

- Point of Diversion (POD)
- Place of Use (POU)
- Storage Tank
- Water Supply Mainlines
- Major Road
- Reservoir (Permit R-14492)
- Watercourse
- Government Lots
- Taxlot

POD Legal Description:

Backup Facility Supply Diversion Located 1850 ft north and 345 ft west of the SE corner of Section 16, Township 6 North, Range 5 West, W.M.
Log Deck Irrigation Diversion Located 2080 ft north and 570 ft west of the SE corner of Section 16, Township 6 North, Range 5 West, W.M.
Fire Pump Diversion Located 2200 ft north and 345 ft west of the SE corner of Section 16, Township 6 North, Range 5 West, W.M.

Disclaimer

This map was prepared for the purpose of identifying the location of a water right only and it is not intended to provide legal dimensions or location of property ownership lines.

Map Notes

Date: May 14, 2012
 Data Sources: RSG Forest Products, Oregon Geospatial Enterprise Office, Columbia County Department of Land Development Services, BLM, ESRI
 Prepared By: GSI Water Solutions, Inc.

