

RECEIVED

FEB 14 2013



# Claim of Beneficial Use Map Permit S-54391 (Application S-86690)

WATER RESOURCES DEPT  
SALEM, OREGON

Water Right in the Name of RSG Forest Products, Inc.

Township 6 North, Range 5 West, Sections 15 & 16 (W.M.)

Certified Water Rights Examiner Stamp

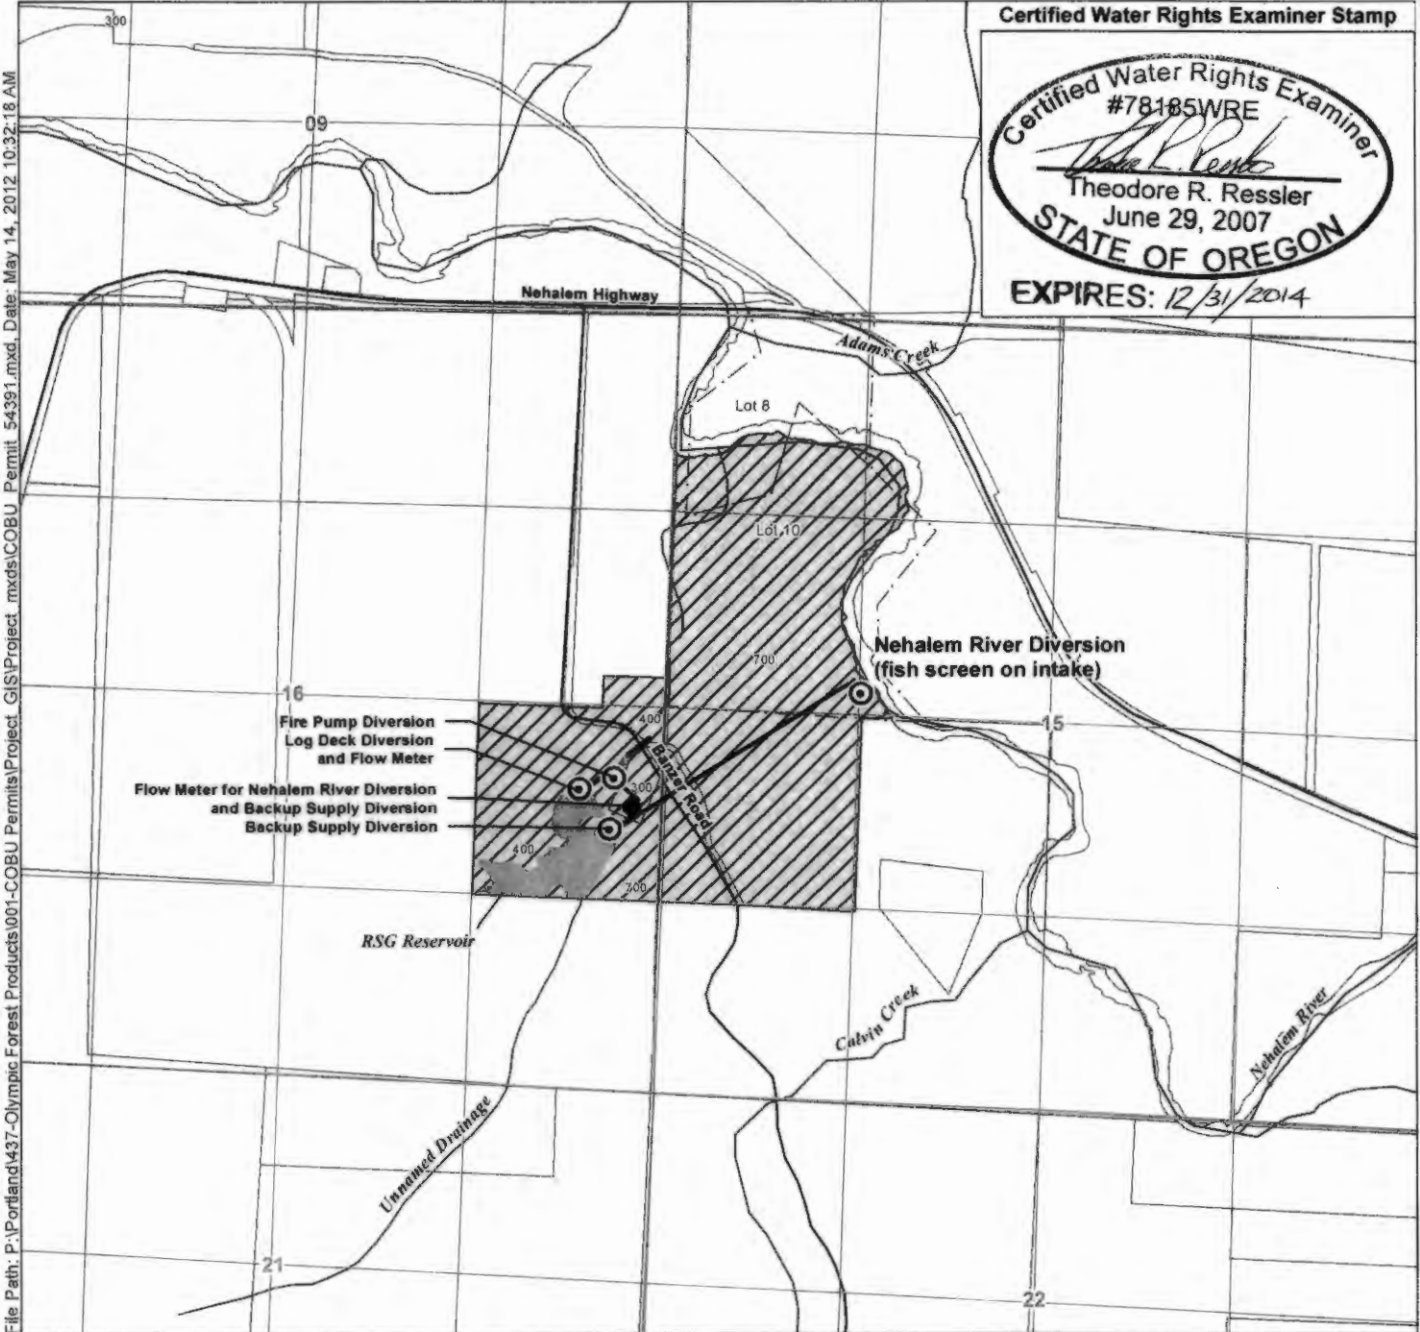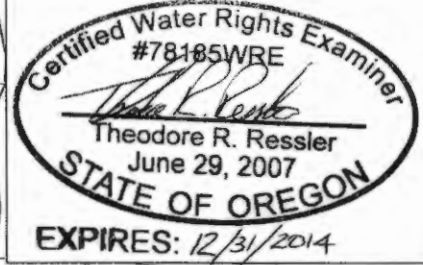

File Path: P:\Portland\437-Olympic Forest Products\1001-COBU Permits\Project\_GIS\Project.mxd, Date: May 14, 2012 10:32:18 AM

### LEGEND

- Point of Diversion (POD)
- Place of Use (POU)
- Storage Tank
- Water Supply Mainlines
- Major Road
- Reservoir (Permit R-14492)
- Watercourse
- Government Lots
- Taxlot

### POD Legal Description:

**Nehalem River Diversion** Located 2860 ft north and 1375 ft east of the SW corner of Section 15, Township 6 North, Range 5 West, W.M.  
**Backup Supply Diversion** Located 1850 ft north and 345 ft west of the SE corner of Section 16, Township 6 North, Range 5 West, W.M.  
**Log Deck Diversion** Located 2080 ft north and 570 ft west of the SE corner of Section 16, Township 6 North, Range 5 West, W.M.  
**Fire Pump Diversion** Located 2200 ft north and 345 ft west of the SE corner of Section 16, Township 6 North, Range 5 West, W.M.

### Disclaimer

This map was prepared for the purpose of identifying the location of a water right only and it is not intended to provide legal dimensions or location of property ownership lines.

### Map Notes

Date: May 14, 2012  
 Data Sources: RSG Forest Products, Oregon Geospatial Enterprise Office, Columbia County Department of Land Development Services, BLM, ESRI  
 Prepared By: GSI Water Solutions, Inc.

