


NORTHEAST CORNER
NATHAN P MACK D.L.C. 3878.8'

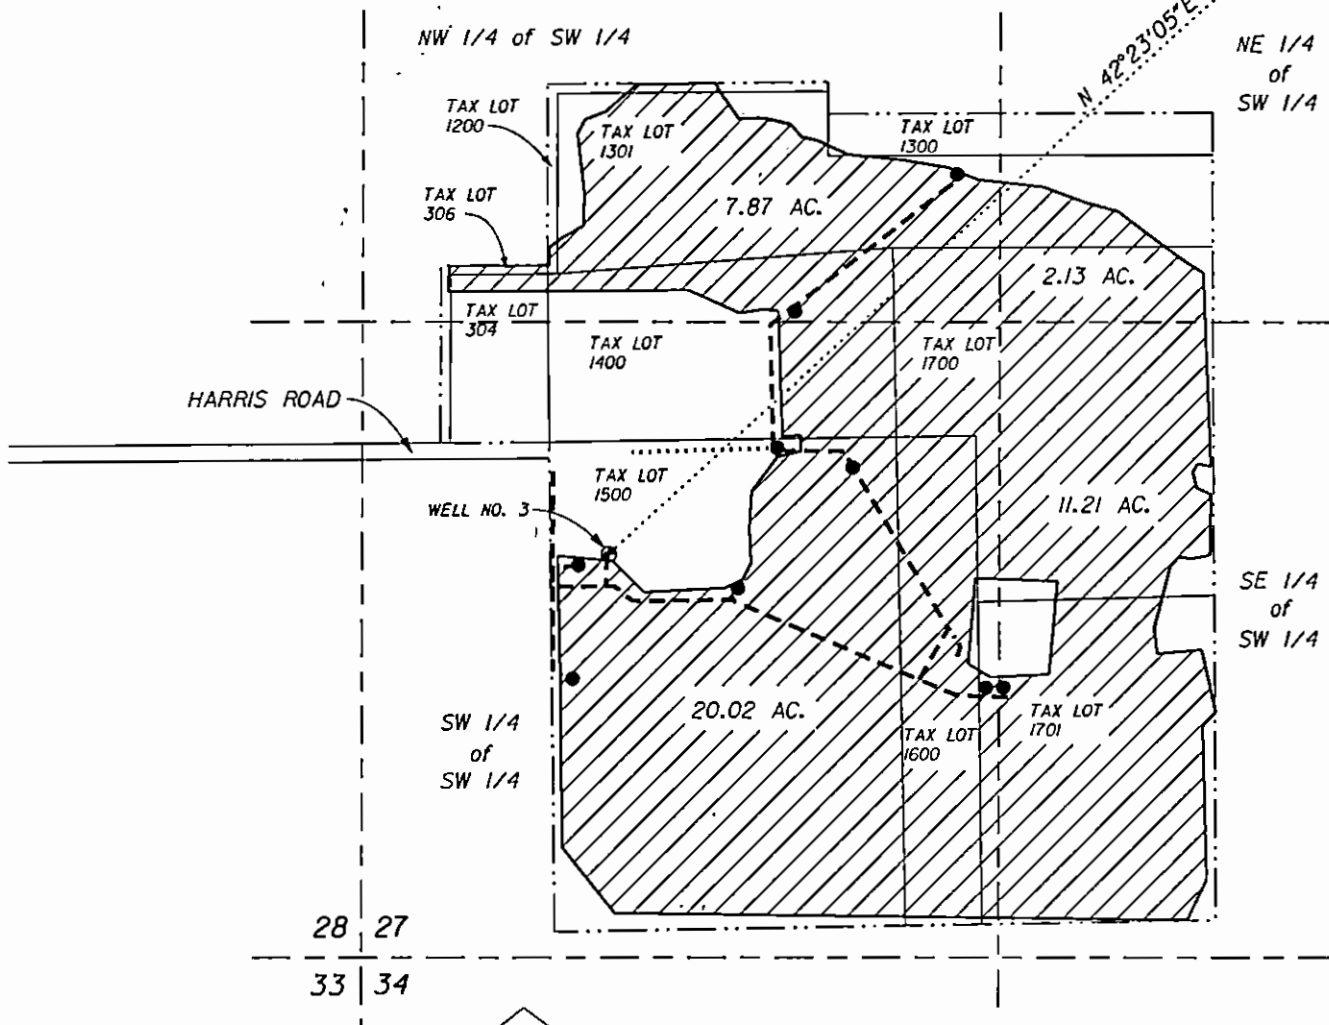


LEGEND:

- IRRIGATED LAND
- BURIED 4\"/>

NOTES:

THIS DRAWING IS A PROOF SURVEY FOR A CLAIM OF BENEFICIAL USE TO PERFECT A GROUND WATER RIGHT. IT IS NOT A LAND SURVEY. PROPERTY LINES AND/OR OTHER LINES OF OCCUPATION SHOWN HEREON ARE NOT REPRESENTED BY THE UNDERSIGNED TO MEET ACCURACY STANDARDS OF LAND SURVEYS.

SECTION CORNER, SECTION LINES & 1/16TH LINES ARE ILLUSTRATIVE ONLY AS ALL ARE WITHIN THE BOUNDS OF D.L.C: NO. 37 AND THUS WERE NEVER PLATTED.

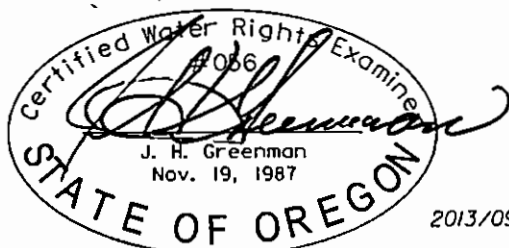

2013/09/26

NATHAN P. MACK DONATION LAND CLAIM RECEIVED
SECTION 27, T.2S., R.3E., W.M.
CLACKAMAS COUNTY, OREGON

41.23 TOTAL ACRES OF
NURSERY STOCK
UNDER IRRIGATION.

SEP 30 2013
WATER RESOURCES DEPT
SALEM, OREGON

APPLICATION No. G-16444
PERMIT No. G-16055

JAMES R. DIERKING
GROUND WATER PROOF SURVEY

H

R

S

HANER, ROSS & SPORSEEN, P.C.

2895 Beaver Creek Road,
Oregon City, OR 97045

L: \HRS_1580\ 1580_DGN\ 1580_PRF_SVY.DGN