


EXHIBIT B

T22S, R36E, W.M.
Harney County, Oregon

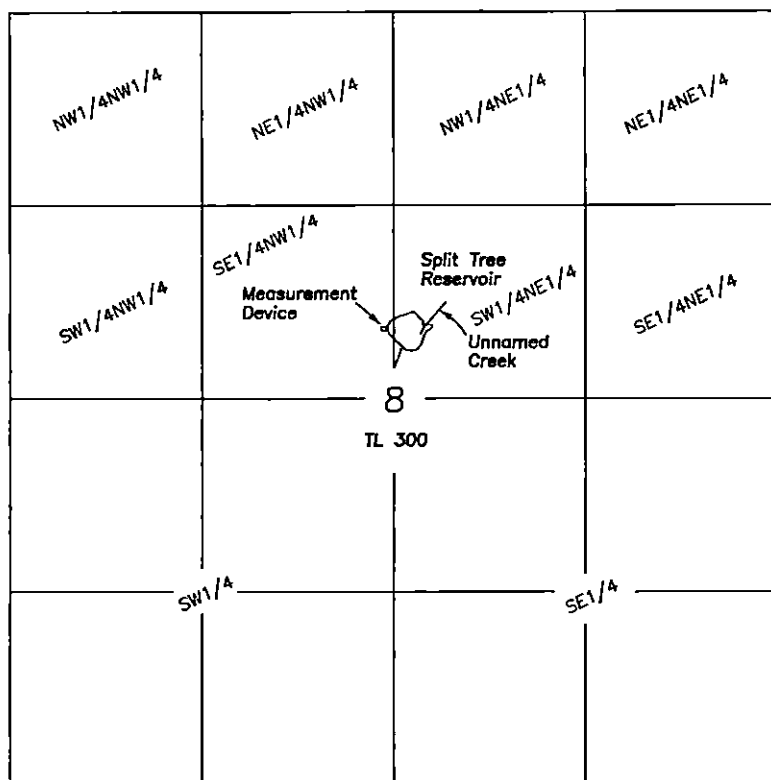

SCALE 1"=1320'

Outlet is located 2150' South & 2510' East of the NW corner of Section 8.

Measuring device is located 3' South of the Outlet.

FINAL PROOF SURVEY
CLAIM OF BENEFICIAL USE
SPLIT TREE RESERVOIR

For

Bureau of Land Management

September 26, 2017

LEGEND

Application No. R-45426

Permit No. R-7888

Priority 9/25/1968

A portion of Tax Lot
22-36 TL300

NOTE: Tax Lot 300 is owned by the BLM
and is more that 21,000 acres.
No boundaries of the tax lot
can be shown.

NOTE: The preparation of this map
was for the purpose of identifying
the location of the proposed water
right and has no intent to provide
dimensions or location of property
ownership lines.

RECEIVED BY OWRD

NOV 03 2017

SALEM, OR

Prepared by
Cornerstone Surveying, Inc

P.O. BOX 33
JOHN DAY, OR. 97845
(541)575-1813

cornerstonesurvey@centurytel.net

