


Claim of Beneficial Use - Place of Use Map
Transfer T-11451
Water Right in the Name of City of Toledo
Lincoln County
Township 11 South, Range 10 West (W.M.)

COBU MAP 1080

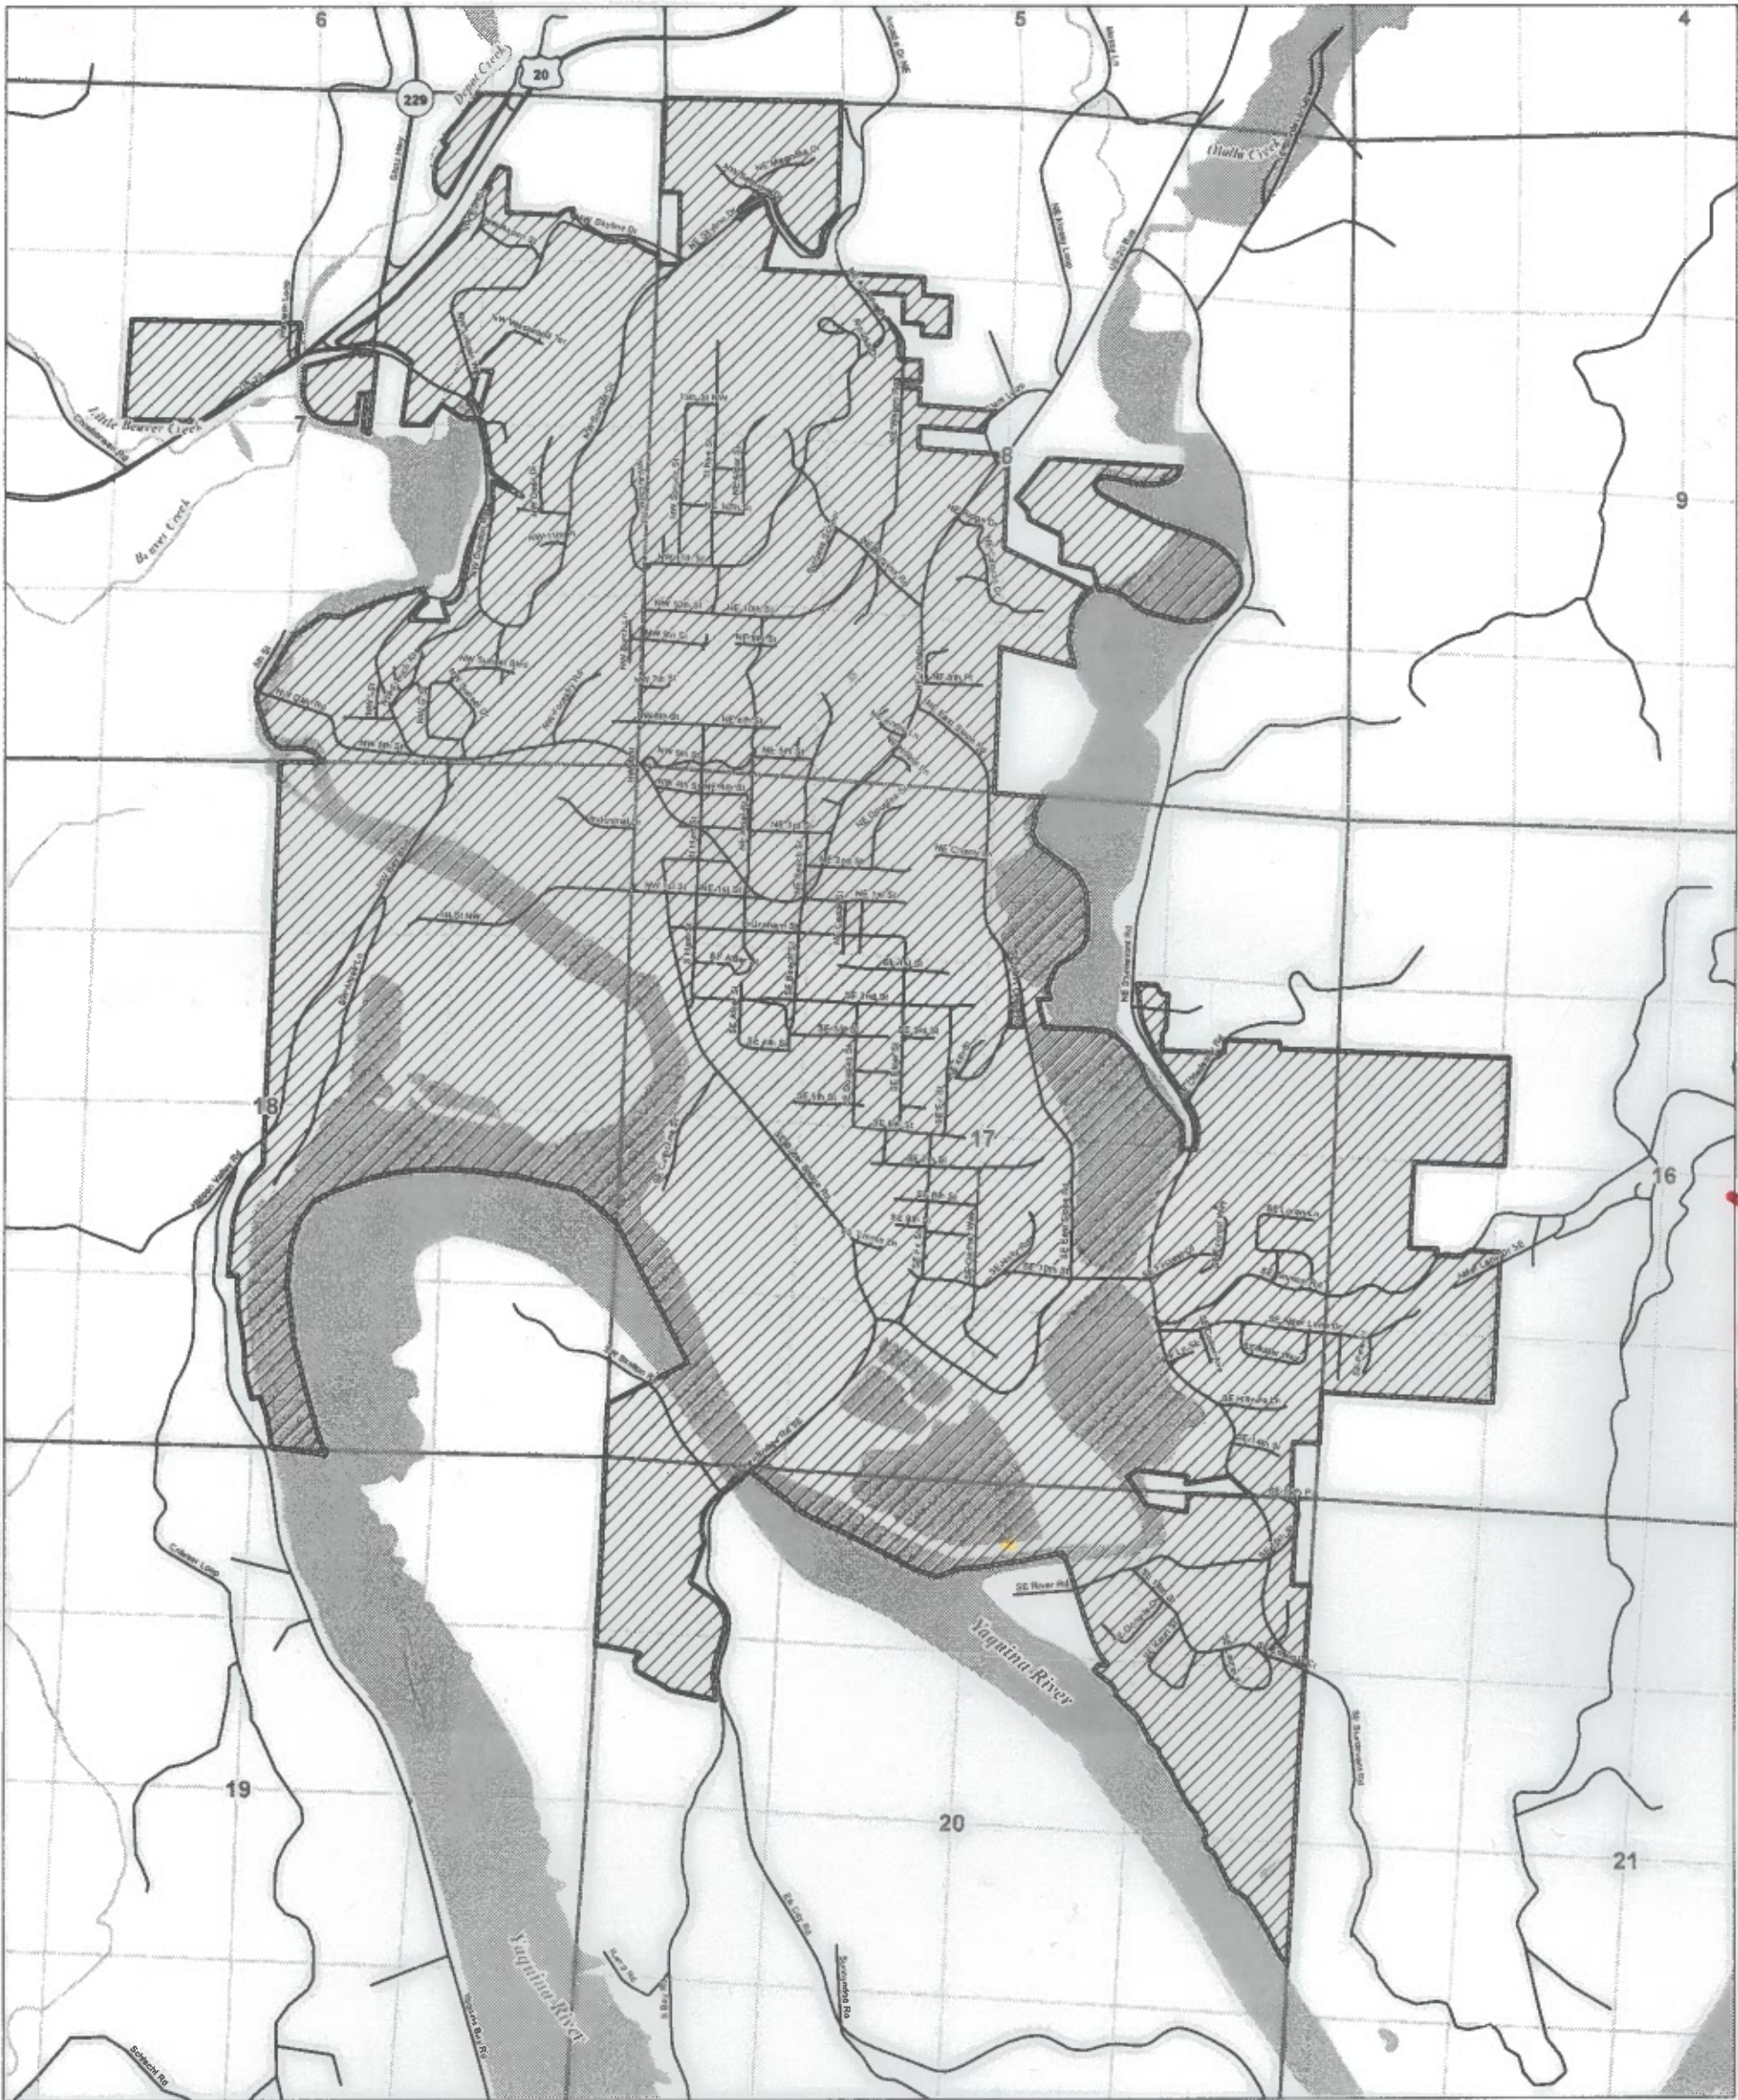

LEGEND

- Place of Use (POU)
- City of Toledo Service Boundary
- Street
- Watercourse
- Waterbody

RECEIVED BY OWRD

MAY 24 2017

SALEM, OR

Certified Water Rights Examiner Stamp

Certified Water Rights Examiner
#78185WRE
Theodore R. Ressler
June 29, 2007
STATE OF OREGON
EXPIRES: 12-31-2018

DISCLAIMER

This map was prepared for the purpose of identifying the location of a water right only and it is not intended to provide legal dimensions or location of property ownership lines.

MAP NOTES

Date: March 31, 2017
Data Sources: OWRD, US BLM, OGIC, ESRI
Prepared By: GSI Water Solutions, Inc.


The Place of Use is "Within the service boundaries of the City of Toledo".

0 660 1,320
1 inch = 1,320 feet

GSI
Water Solutions, Inc.

Claim of Beneficial Use - Point of Diversion Map Transfer T-11451

Water Right in the Name of City of Toledo
Lincoln County
Township 10 South, Range 10 West (W.M.)

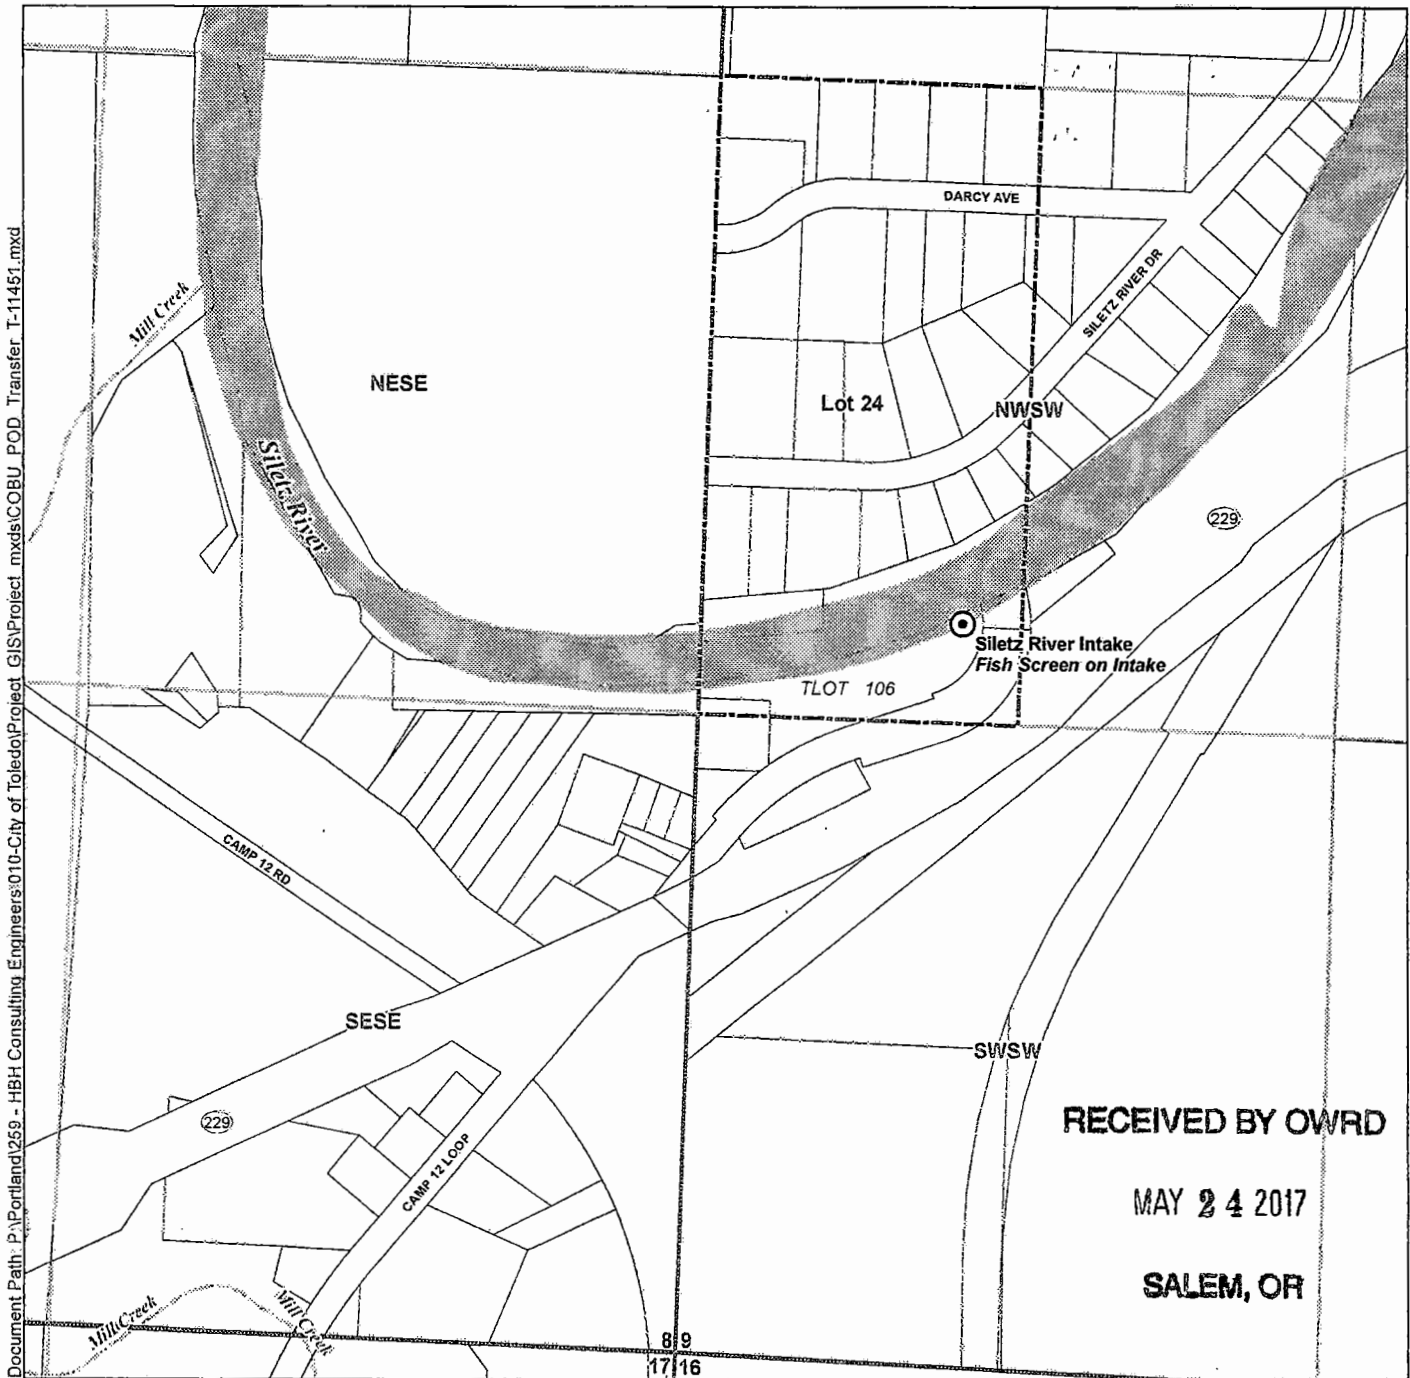


LEGEND

- Point of Diversion (POD)
- Tax Lot
- Government Lot
- Watercourse
- Waterbody

POD LOCATION DESCRIPTION

Siletz River Intake
Located 1,545 feet North and 540 feet East from the SW corner of Section 9, Township 10 South, Range 10 West (W.M.)

Certified Water Rights Examiner Stamp

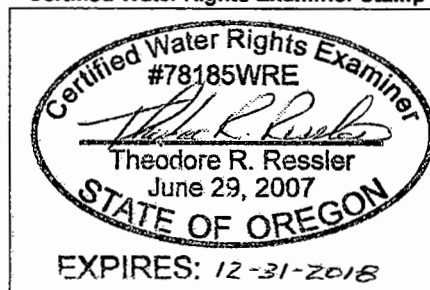

DISCLAIMER

This map was prepared for the purpose of identifying the location of a water right only and it is not intended to provide legal dimensions or location of property ownership lines.

MAP NOTES

Date: March 31, 2017
Data Sources: OWRD, OGIC, US BLM
Prepared By: GSI Water Solutions, Inc.

